

Levels:

Wall top edge	+3.07m
Clay tiles top edge	+3.00m
Steel framing top edges	+2.81m
Suspended ceiling	+2.77m

OSB Panels

Oriented Strand Boards
2500x1250x15mm

Floor	+0.53m
Steel framing bottom edge	+0.27m
Ground level	+0.00m




Levels:

Wall top edge	+3.07m
Clay tiles top edge	+3.00m
Steel framing top edges	+2.81m
Suspended ceiling	+2.77m


Steel framing

- Galvanized steel C-shaped profile: 110x70x20x1mm.
- Galvanized steel U-shaped profile: 114x70x1mm.




Floor	+0.53m
Steel framing bottom edge	+0.27m
Ground level	+0.00m

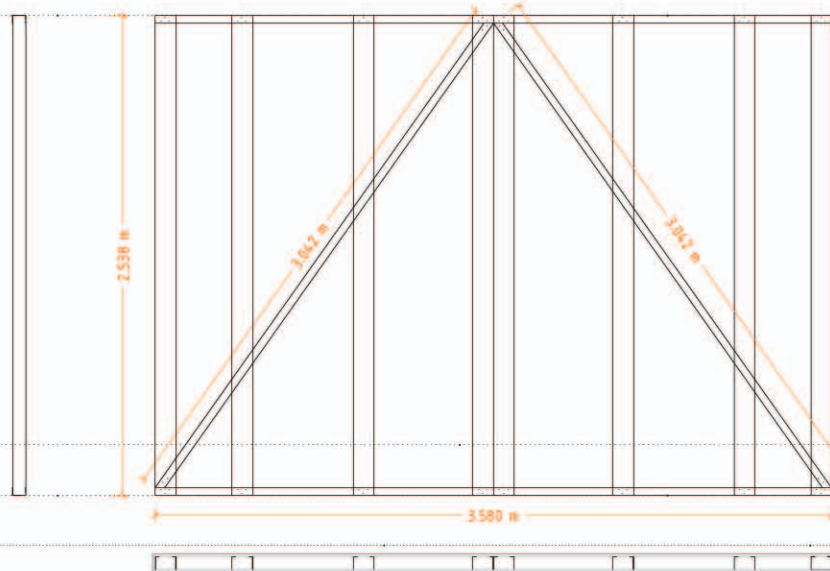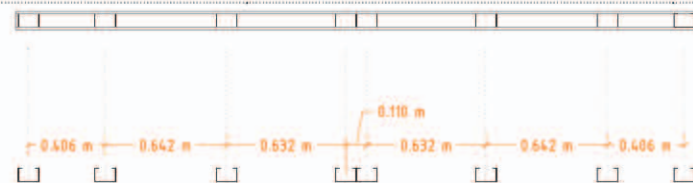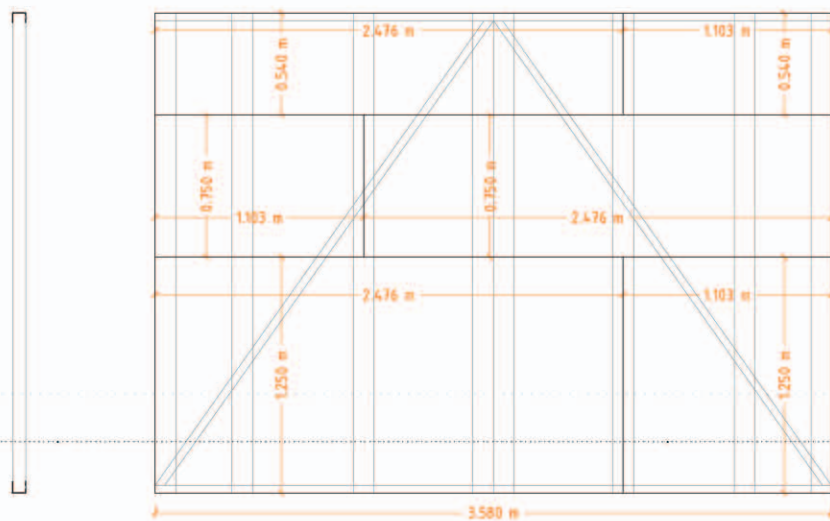




Load-bearing wall M

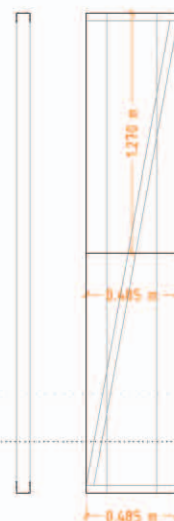


Load-bearing wall Q1/Q2

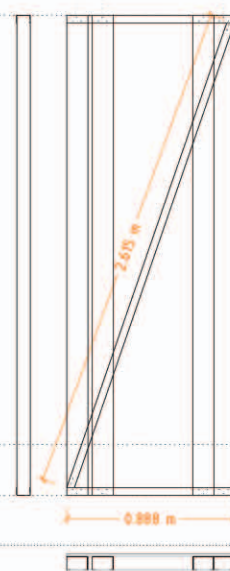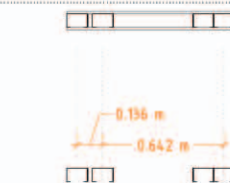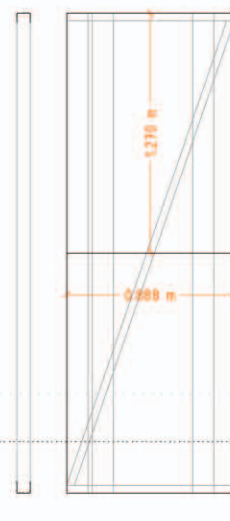

Load-bearing wall P

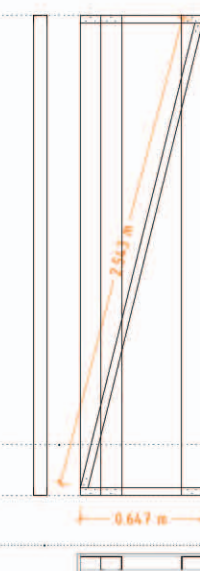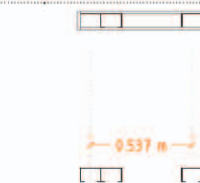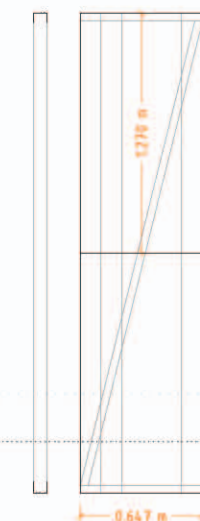

Load-bearing wall J

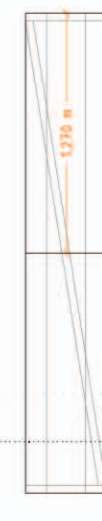


Load-bearing wall F1/F2



S - 20

DATE: 08.04.2005

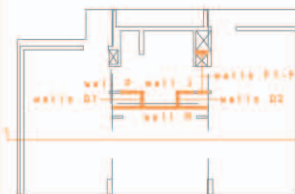

SCALE_1:40



COORDINATORS SUPERVISORS DECATHLETES

DANIEL CARDOSO
plan designer

CARLOS BERMEJO
design coordinator

MIGUEL GOMEZ
general coordinator

JOE WORCESTER
professional engineer

ALFONSO GARCIA-SANTOS
construction manager

JAVIER NEILA
architecture manager

ESTEFANIA CAAMAÑO
general coordinator



Intelling under the sun
Universidad Politécnica de Madrid (UPM)

06/07

S - 20

1:40

MAIN STRUCTURE: INT. WALLS 1