


AREA 2

BATTERY ROOM ROOF AND WALL STRUCTURE







BATTERY ROOM

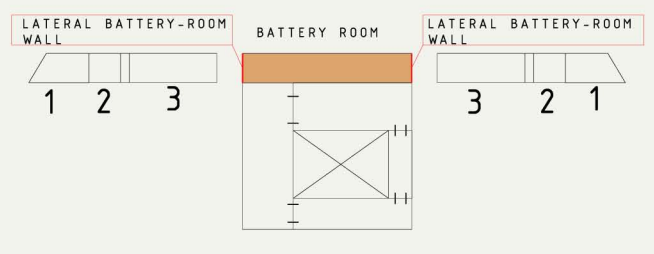


WALL STRUCTURE

BATTERY ROOM

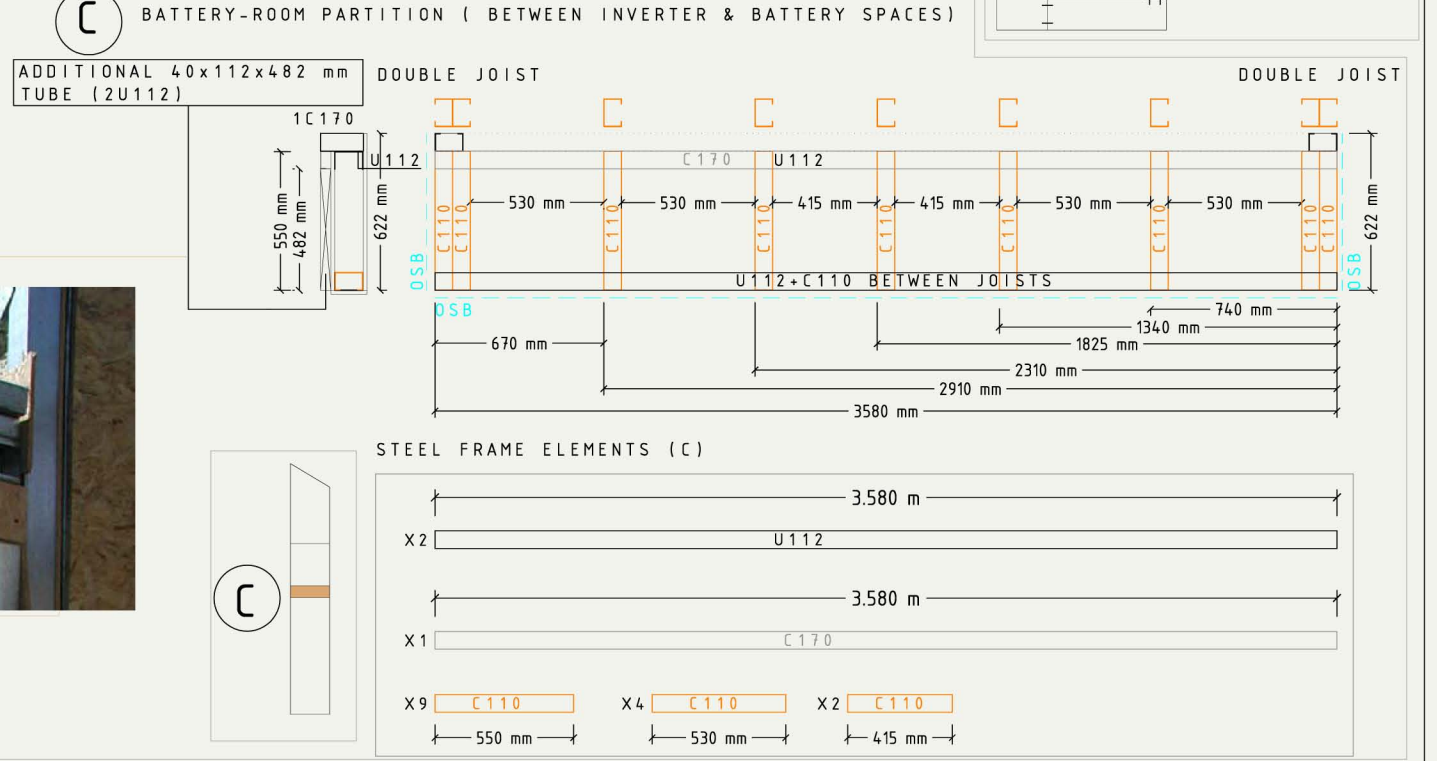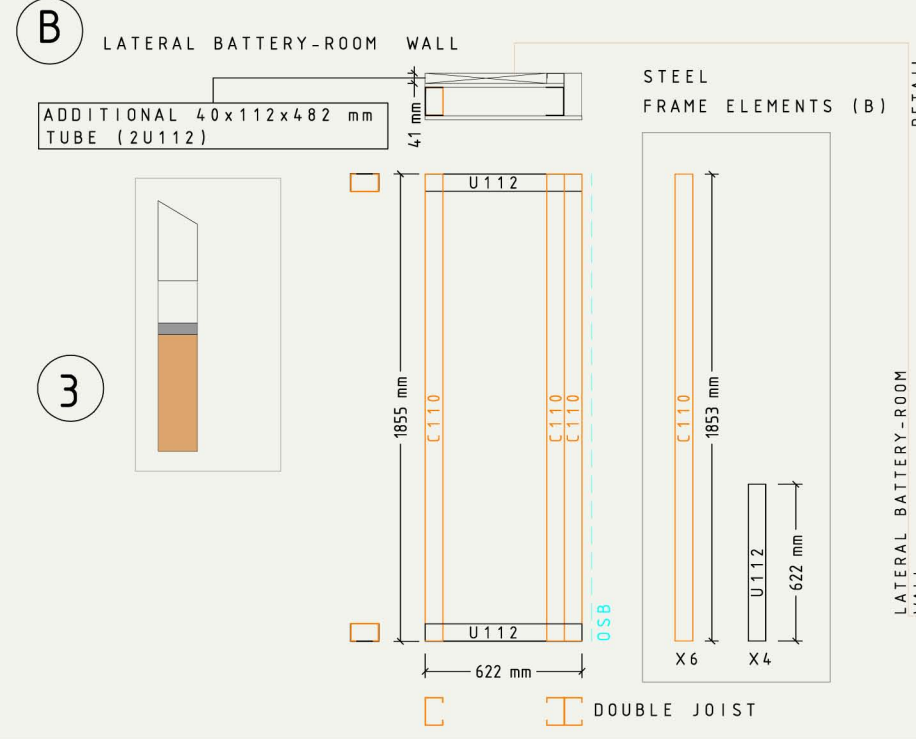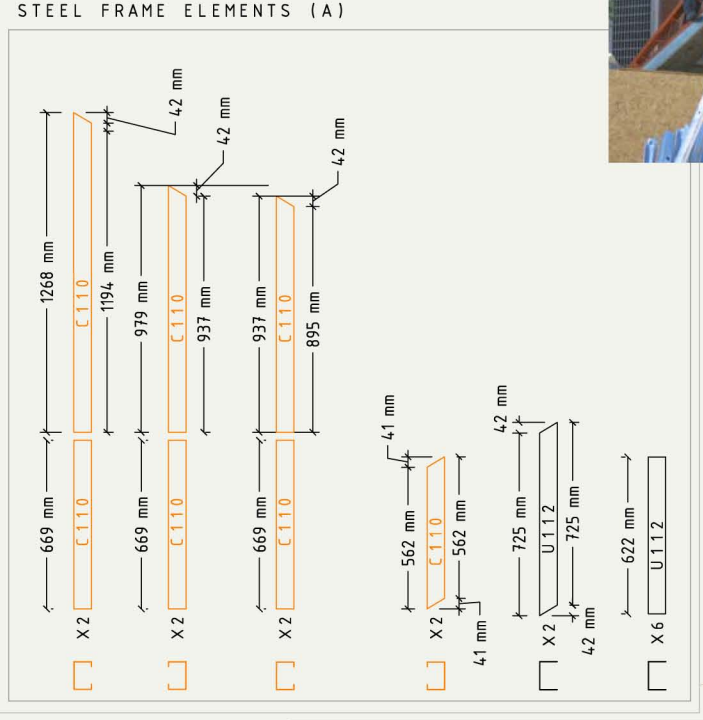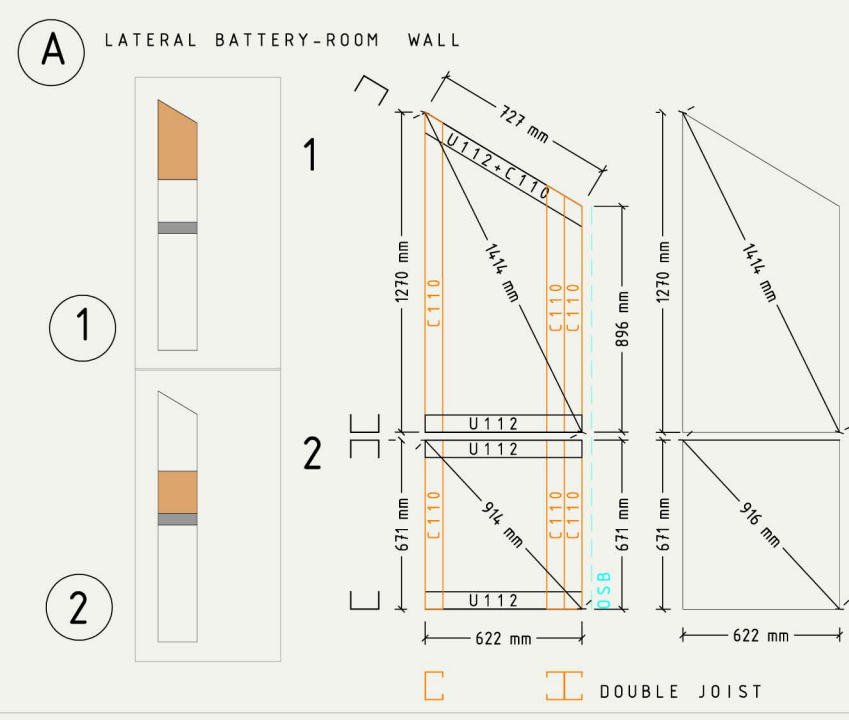

S - 22

DATE : 08.04.2005

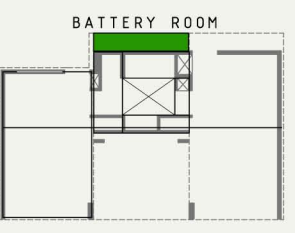

SCALE 1:30



LETICIA RO-BER
plan designer

CARLOS BERMEJO
design coordinator

MIGUEL GOMEZ
general coordinator

JOE WORCESTER
professional engineer

ALFONSO GARCÍA-SANTOS
construction manager

JAVIER NEILA
architecture manager

ESTEFANÍA CAAMAÑO
general coordinator



11/11

S - 22

1:30

STEEL FRAMING: ROOF LAYOUT