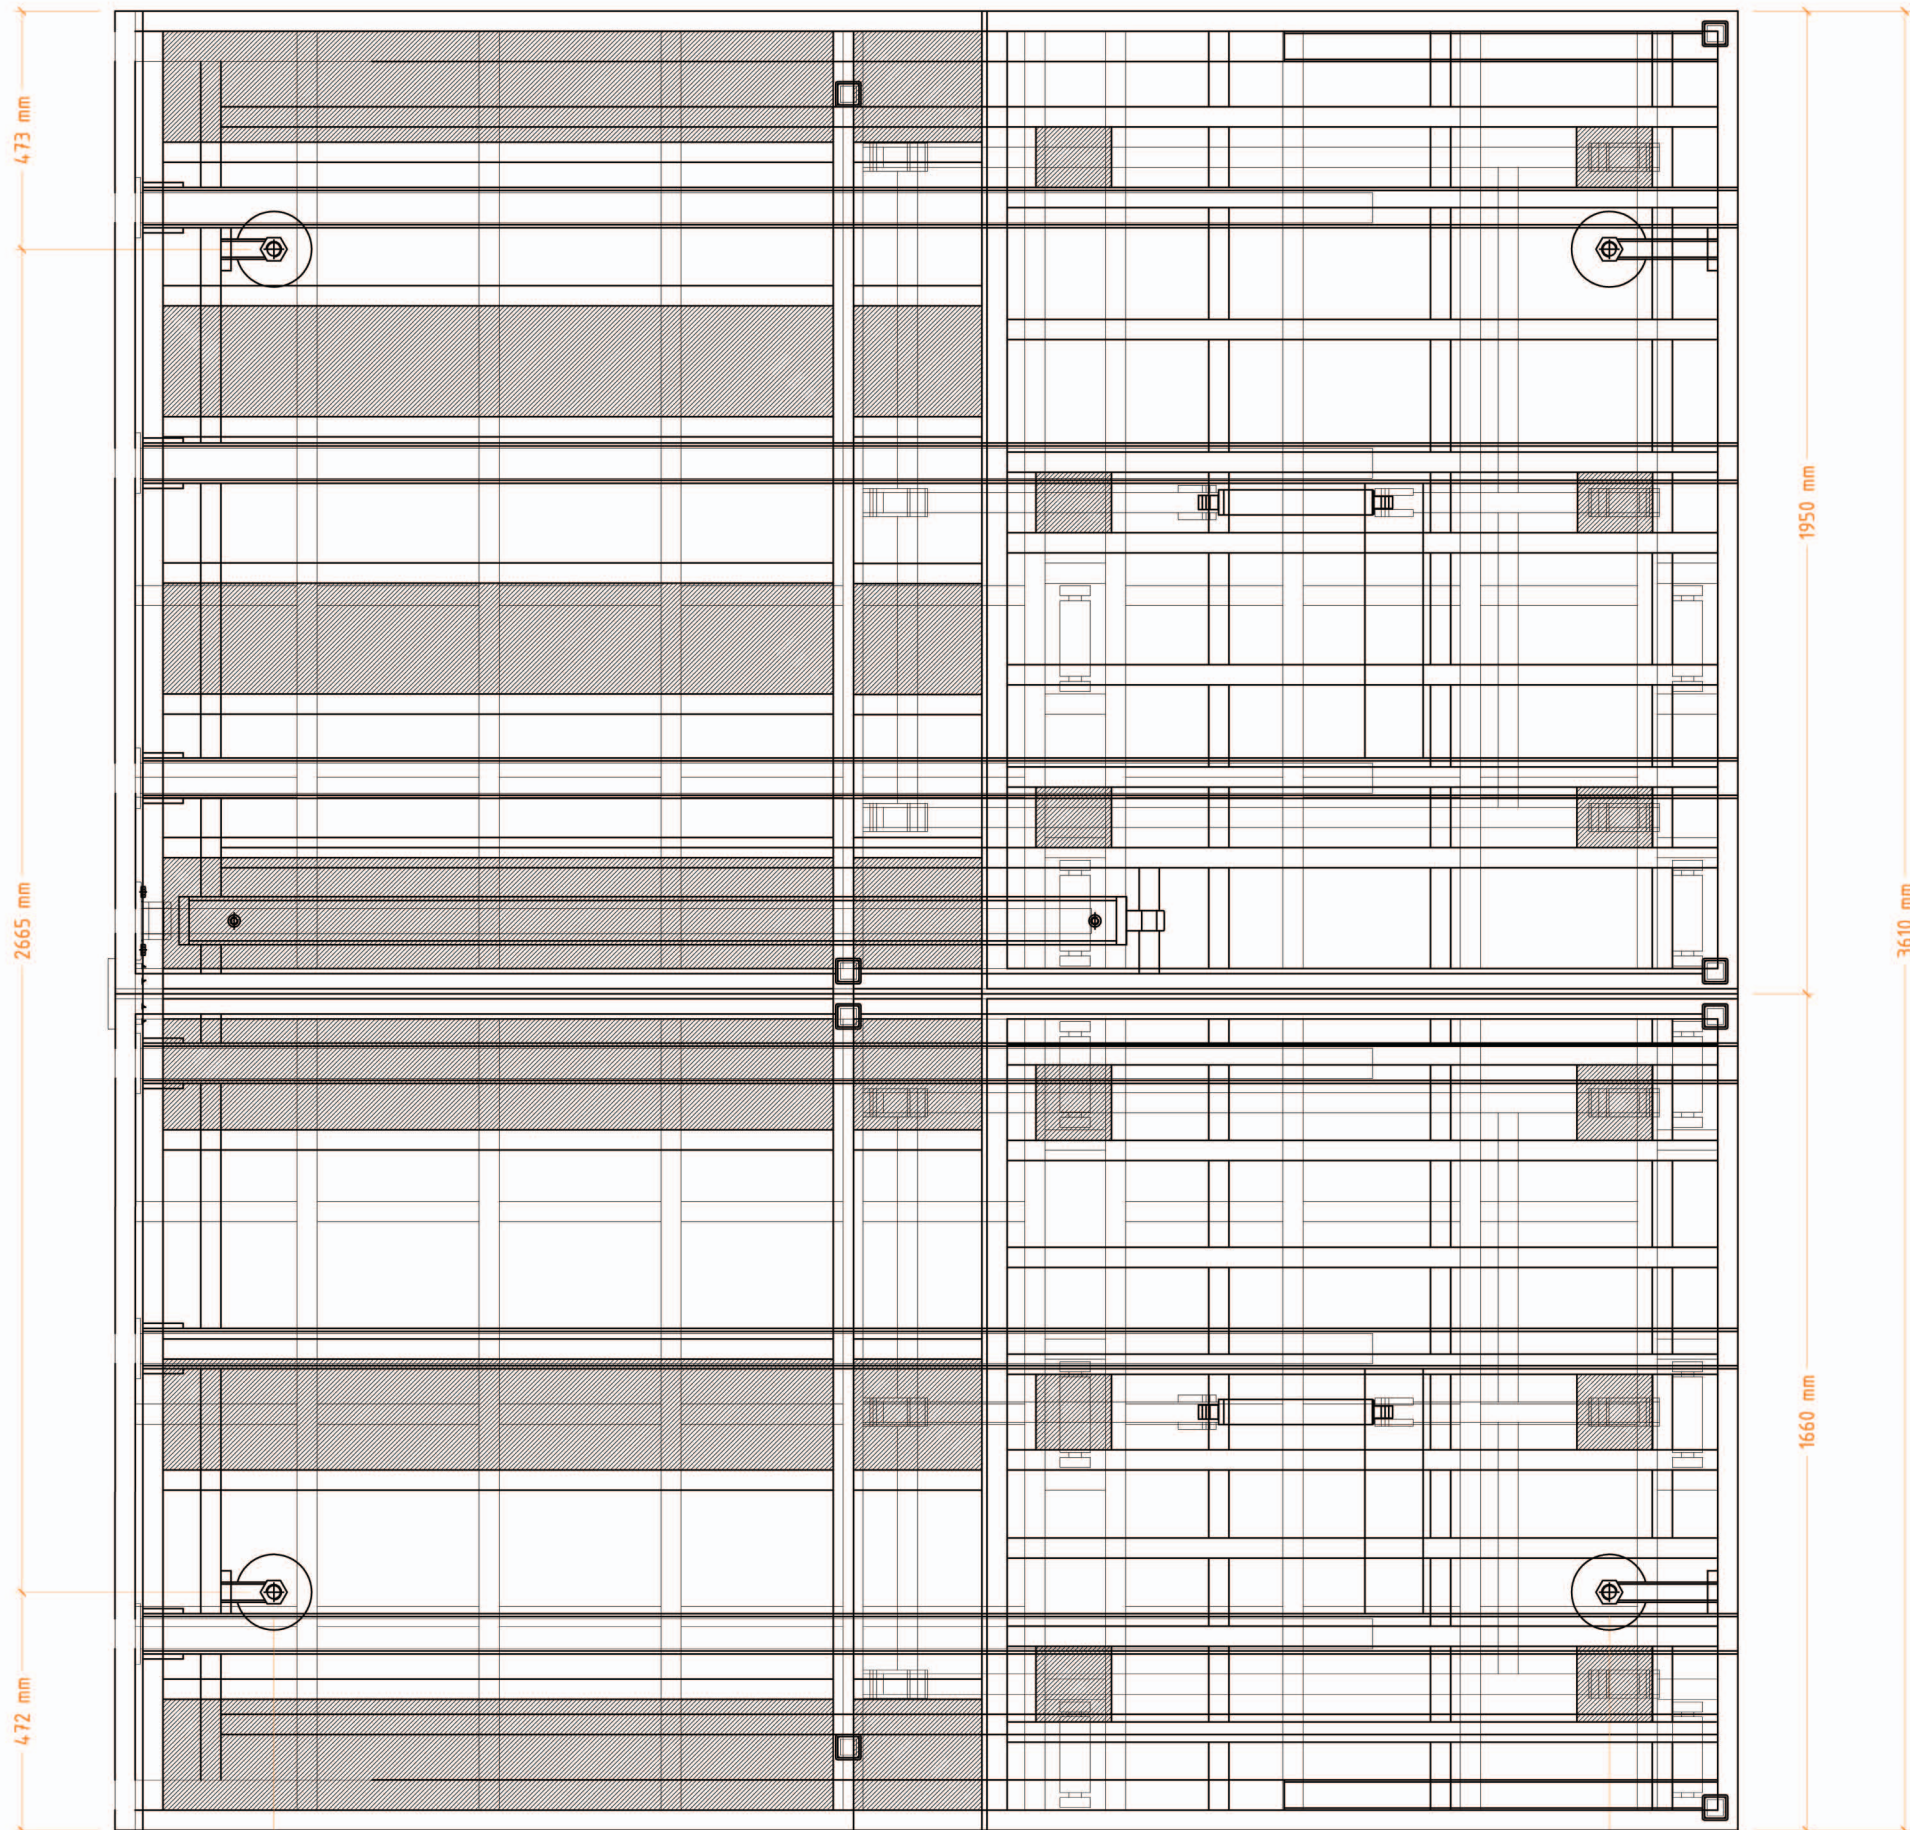
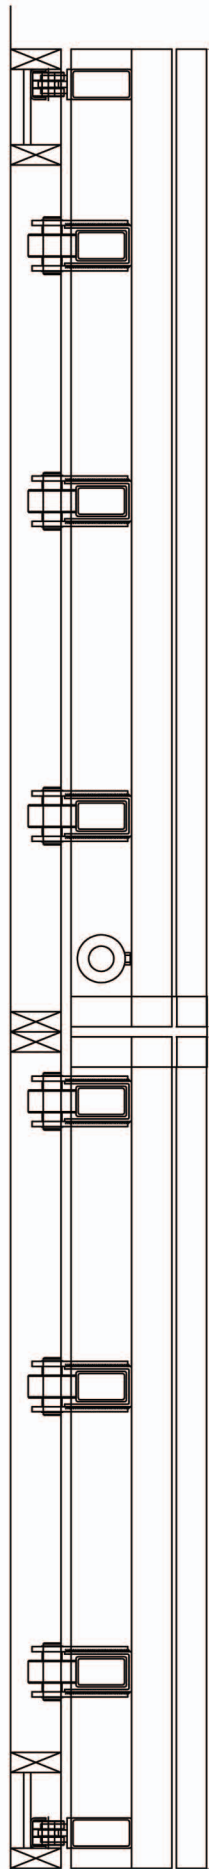

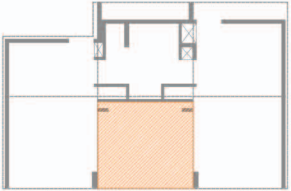
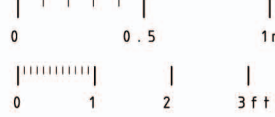



MOBILE BOX FLOOR STRUCTURE AND MECHANISMS



SOUTH ELEVATION



		S - 19 DATE: 08.04.2005		S - 19 02/06
		SCALE_1:30 		
COORDINATORS ALFONSO GARCIA-SANTOS construction manager JAVIER NEILA architecture manager ESTEFANIA CAAMAÑO general coordinator		SUPERVISORS JOAQUIN HIDALGO plan designer CARLOS BERMEJO design coordinator MIGUEL GOMEZ general coordinator		MOVABLE MODULE
 unfolding under the sun Universidad Politécnica de Madrid (UPM)				