

## Secondary framing

### Levels:

Wall top edge	+3.000m
Clay tiles top edge	+2.916m
Steel framing top edges	+2.731m
Suspended ceiling	+2.695m

- 1 Extruded aluminum furring channel  
2 Extruded aluminum corner key  
3 Stainless steel clip

Floor	+0.465m
Steel framing bottom edge	+0.195m
Ground level	+0.000m +0.070m


## Clay tiles

### Levels:

Wall top edge	+3.000m
Clay tiles top edge	+2.916m
Steel framing top edges	+2.731m
Suspended ceiling	+2.695m


- 4 Clay tile  
5 Stainless steel plate

Floor	+0.465m
Steel framing bottom edge	+0.195m
Ground level	+0.000m +0.070m

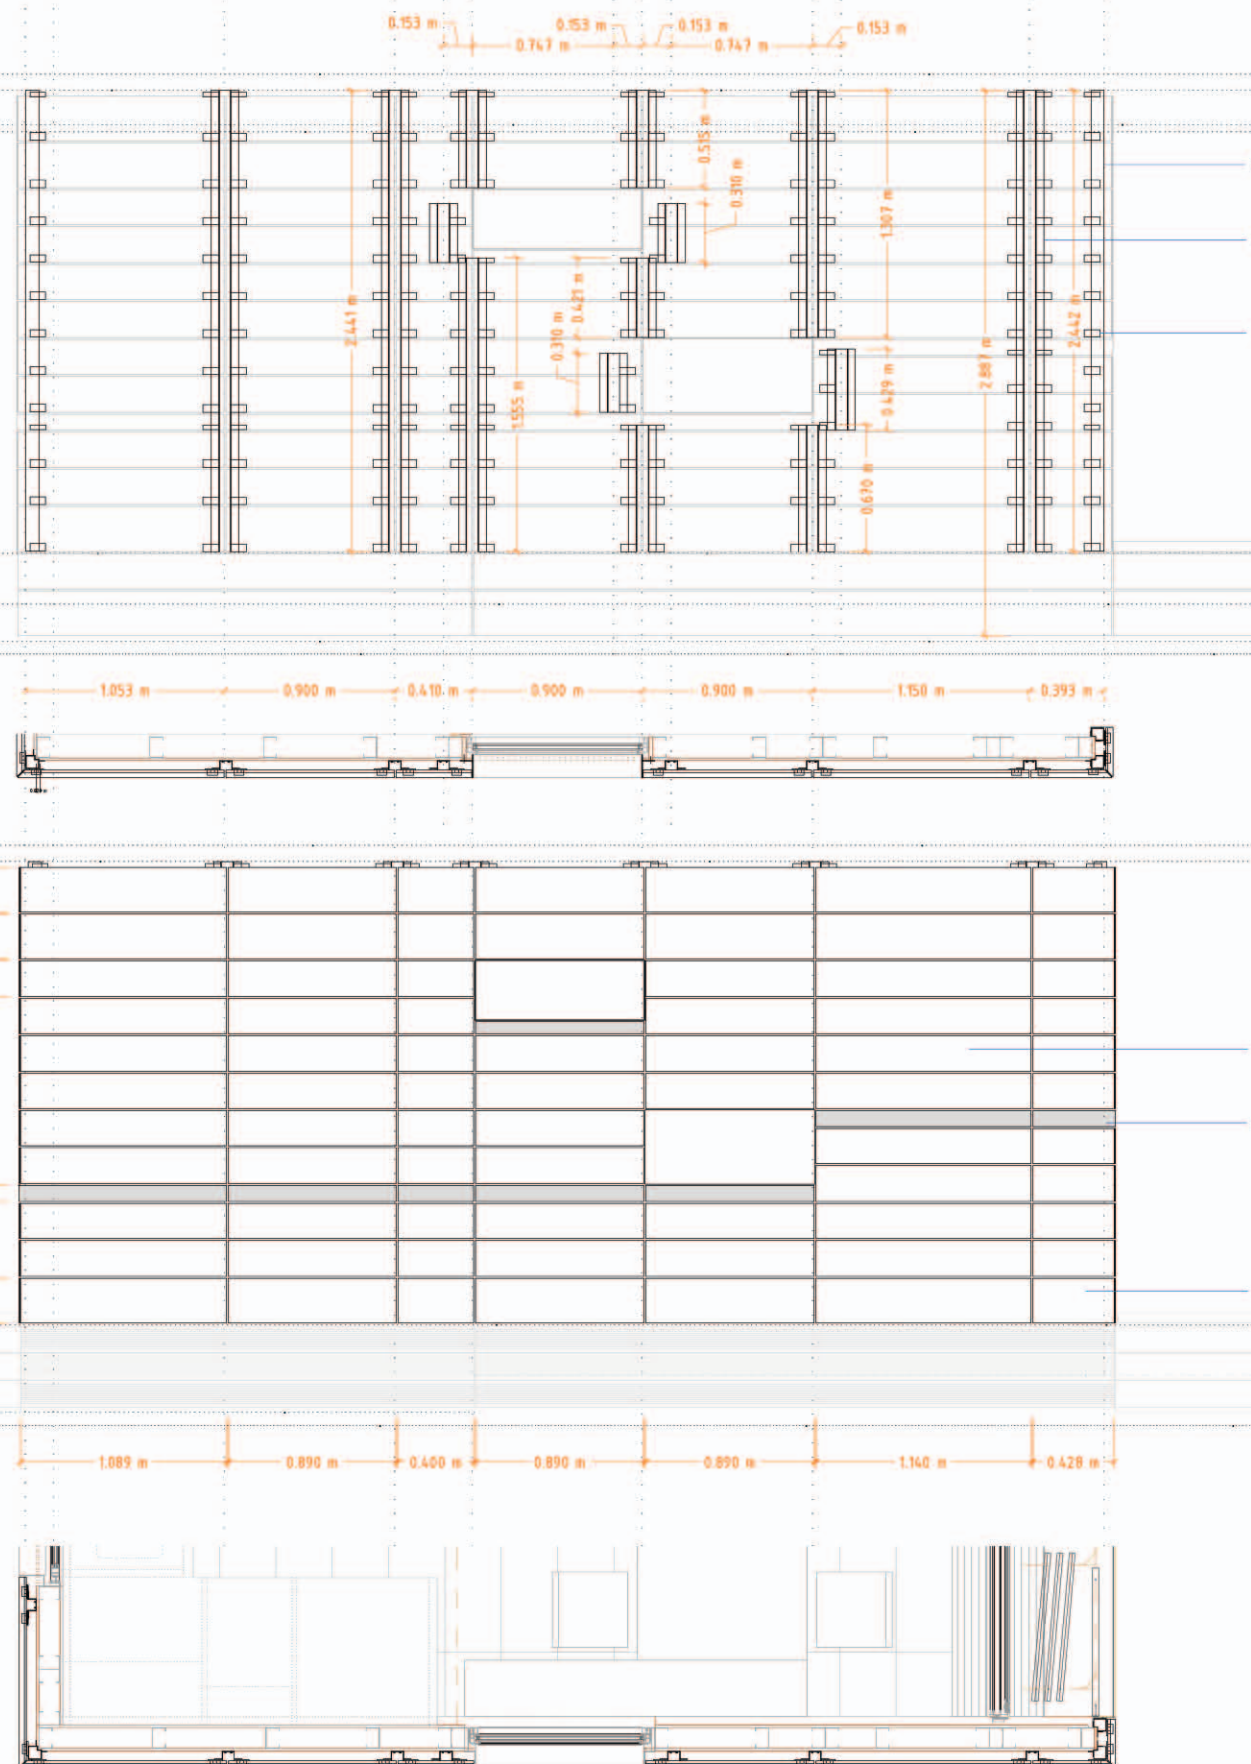


BC-43

DATE: 08.04.2005

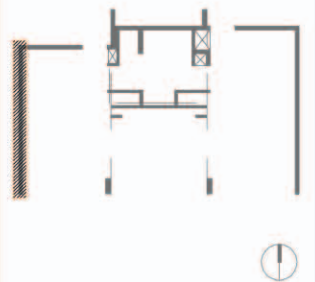

SCALE\_1:40

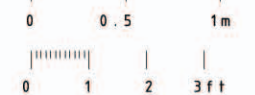

COORDINATORS SUPERVISORS DECATHLETES

DANIEL CARDOSO  
plan designer

CARLOS BERMEJO  
design coordinator

MIGUEL GOMEZ  
general coordinator

ALFONSO GARCIA-SANTOS  
construction manager

JAVIER NEILA  
architecture manager

ESTEFANIA CAAMAÑO  
general coordinator



Intelling inner the sun  
Universidad Politécnica de Madrid (UPM)

02/04

BC-43

1:40

EXT.FINISH:CLAY TILES - WEST