



SLOPED ROOF LAYOUT


SLOPED ROOF LAYOUT (2)

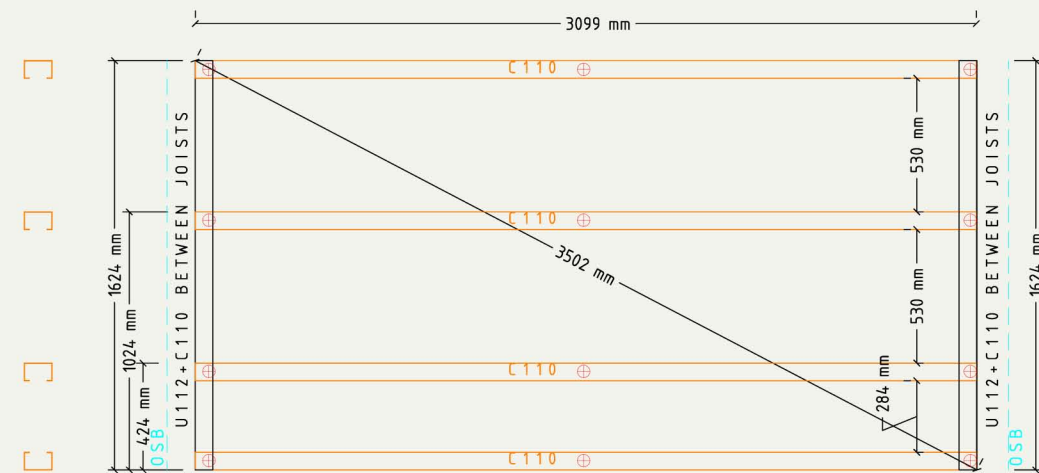


STEEL FRAME ELEMENTS(SLOPED ROOF 2)

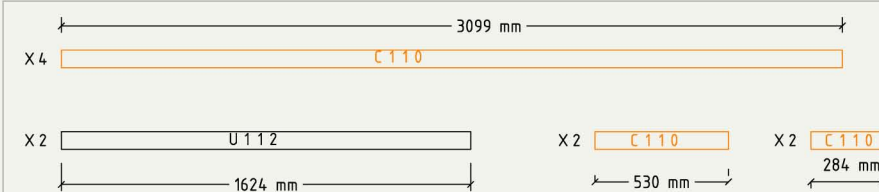

SLOPED ROOF LAYOUT (1)

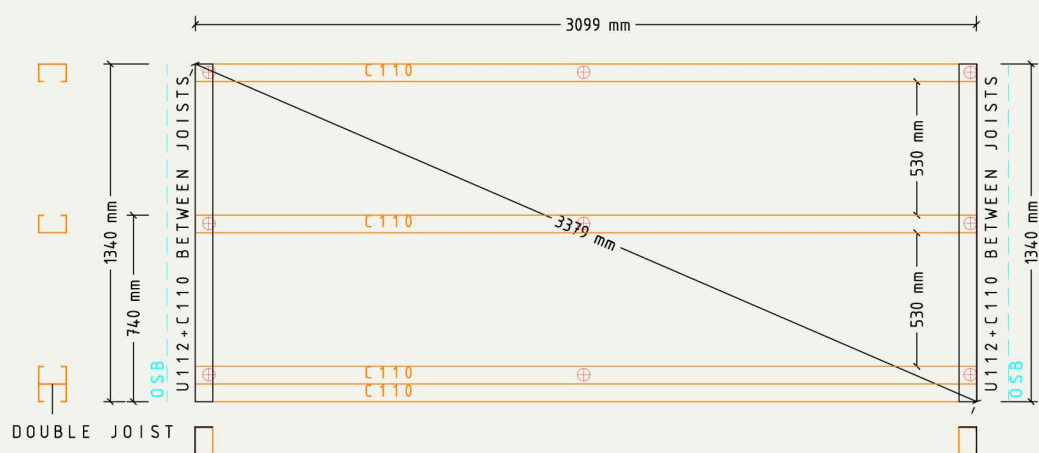


STEEL FRAME ELEMENTS(SLOPED ROOF 1)

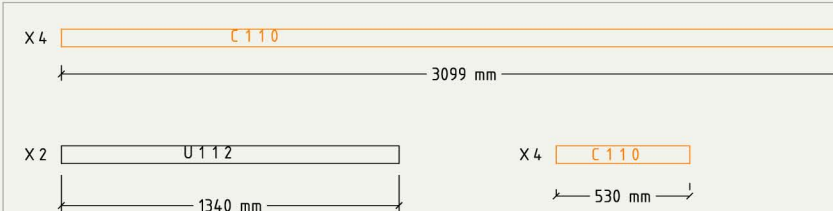


AREA 3
SLOPED ROOF LAYOUT (BEDROOM AREA)

(C)

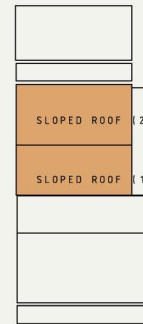


SLOPED ROOF

D SLOPED ROOF LAYOUT

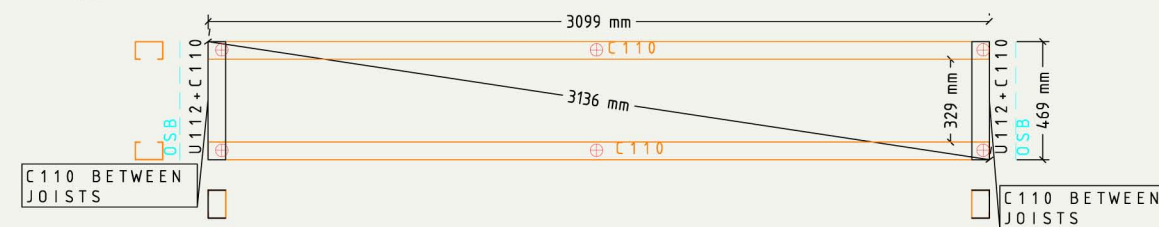


STEEL FRAME ELEMENTS(D)

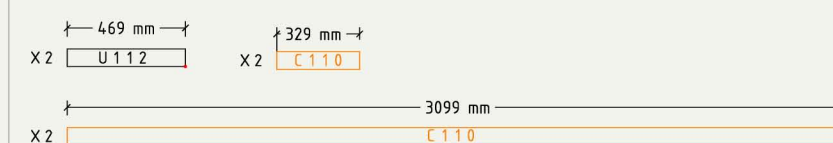

S - 22

DATE: 08.04.2005

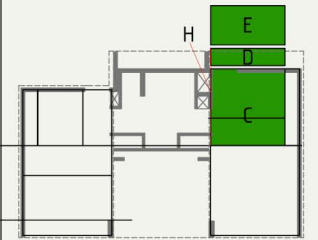

06/11

S-22

SCALE_1:30



1:30

D E C A T H L E T E S

LETICIA RO-BER
plan designer

CARLOS BERMEJO
design coordinator

MIGUEL GOMEZ
general coordinator

COORDINATORS SU

JOE WORCESTER
professional engineer

ALFONSO GARCÍA-SANTOS
construction manager

JAVIER NEILA
architecture manager

ESTEFANÍA CAAMAÑO
general coordinator



Universidad Politécnica de Madrid (UPM)