




SECTION OUTDOOR AREA C

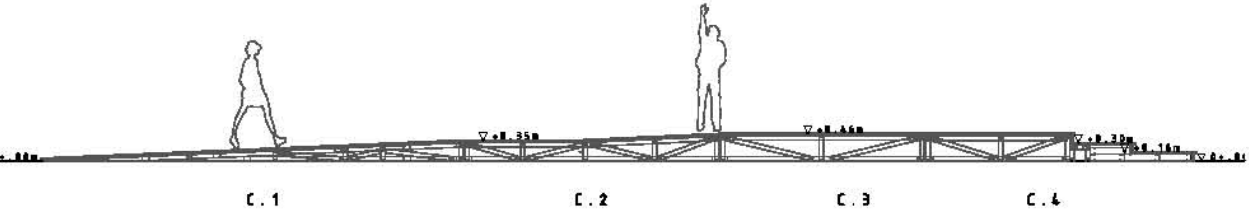


SECTION OUTDOOR AREA C.1

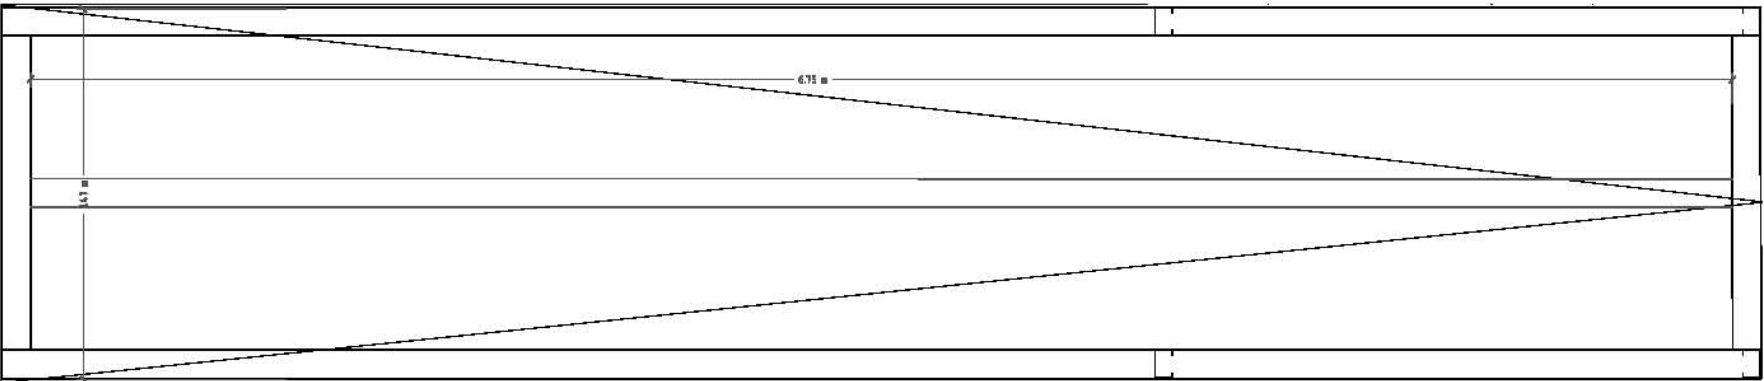


TOP OUTDOOR AREA C.1

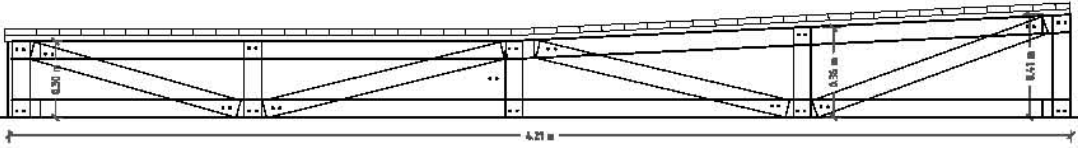


SECTION OUTDOOR AREA C.2

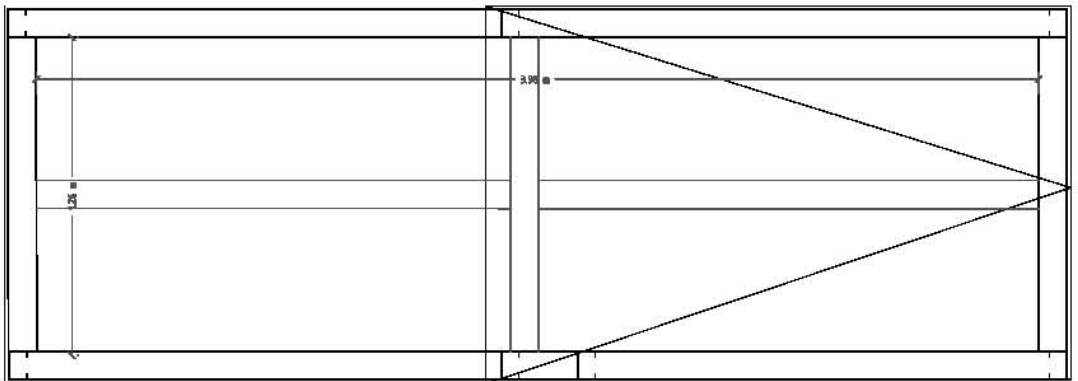


TOP OUTDOOR AREA C.2

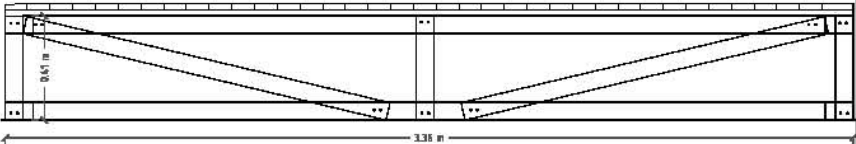


SECTION OUTDOOR AREA C.3

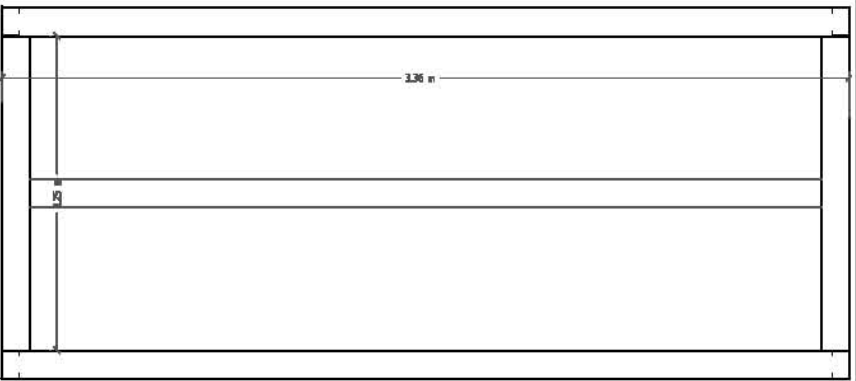

TOP OUTDOOR AREA C.3

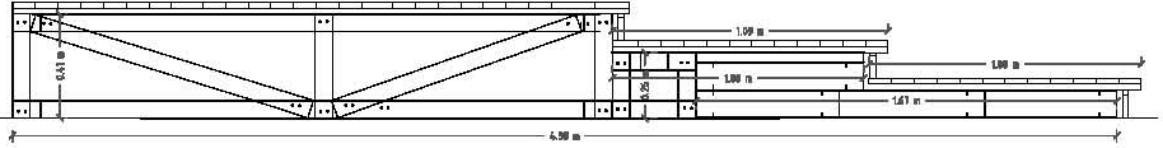

SECTION OUTDOOR AREA C.4

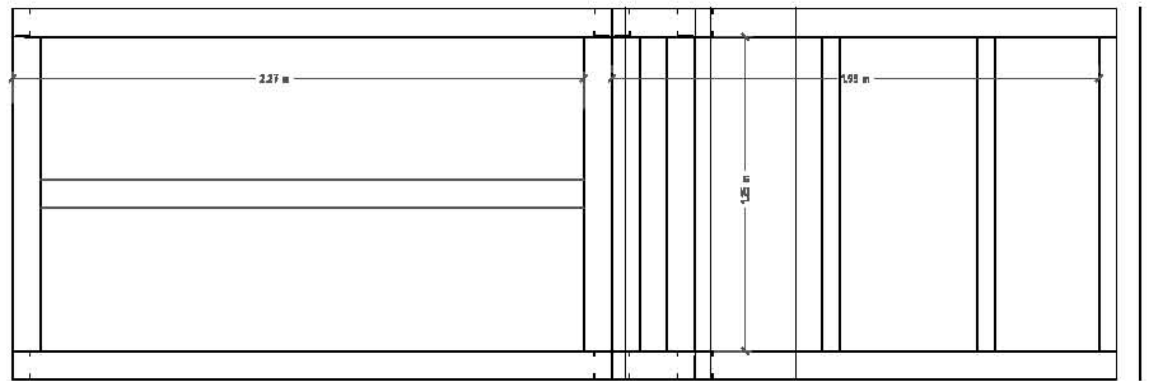


TOP OUTDOOR AREA C.4




BC-50

DATE: 08.04.2005

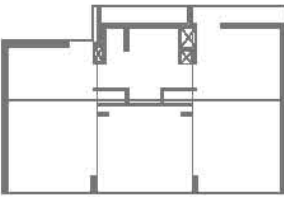

SCALE_1:30

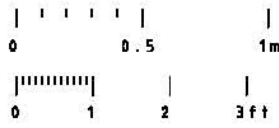

MERCEDES PEÑA,
ISABEL MONTANES
plan designer

CARLOS BERMEJO
design coordinator

MIGUEL GOMEZ
general coordinator

JOE WORCESTER
professional engineer

ALFONSO GARCIA-SANTOS
construction manager

JAVIER NEILA
architecture manager

ESTEFANIA CAAMAÑO
general coordinator



04/7

BC-50

1:30

OUTDOORS AREAS