





SECTION OUTDOOR AREA A.1
1/20SECTION OUTDOOR AREA A.2
1/20SECTION OUTDOOR AREA A.3-garage
1/30

TOP OUTDOOR AREA A.1
1/20

TOP OUTDOOR AREA A.2
1/20TOP OUTDOOR AREA A.3-garage
1/30

BC - 50

DATE: 08.04.2005

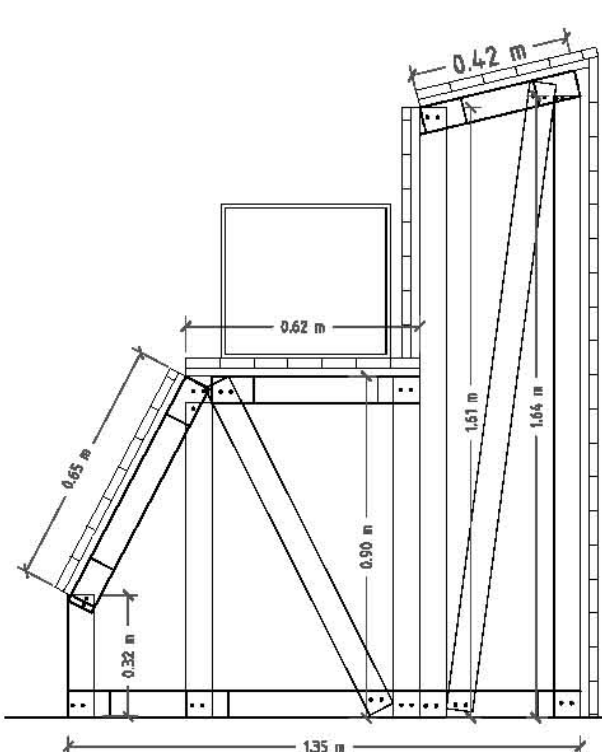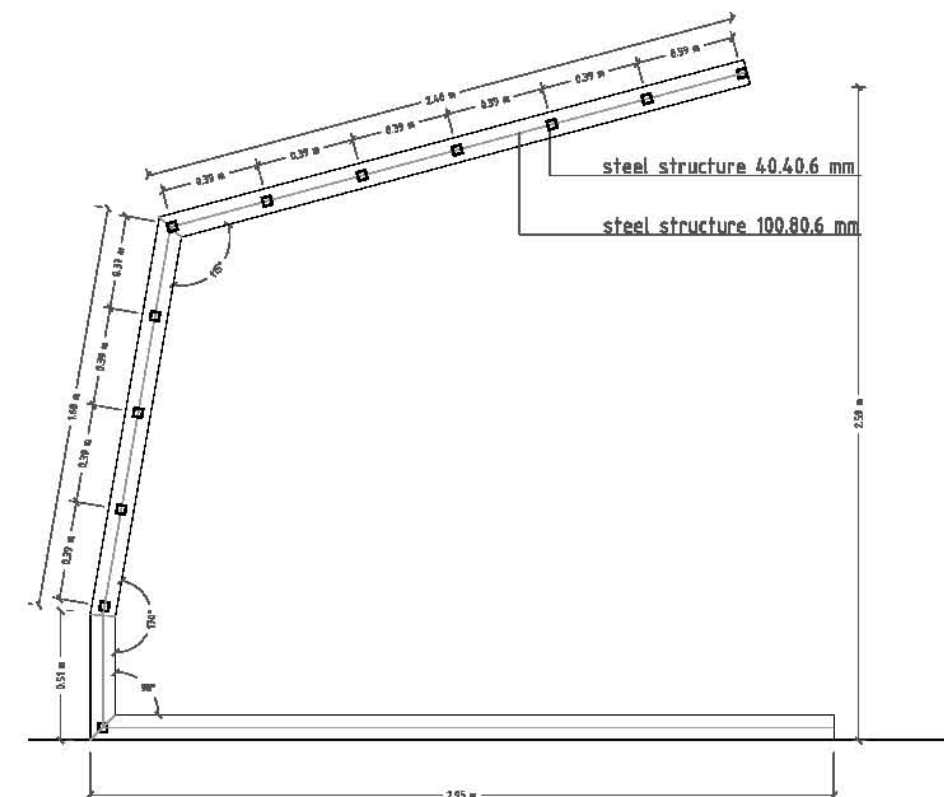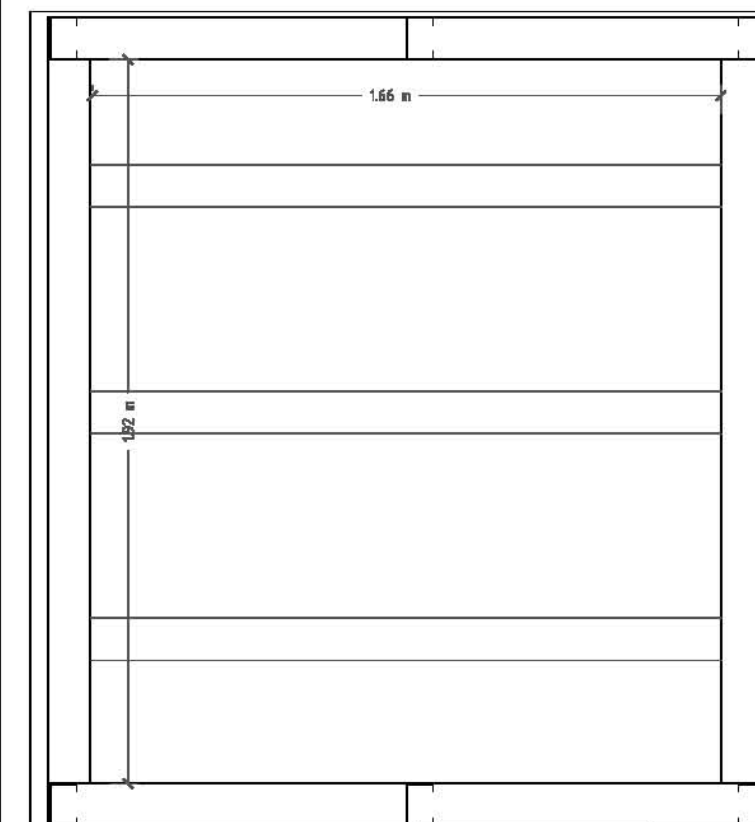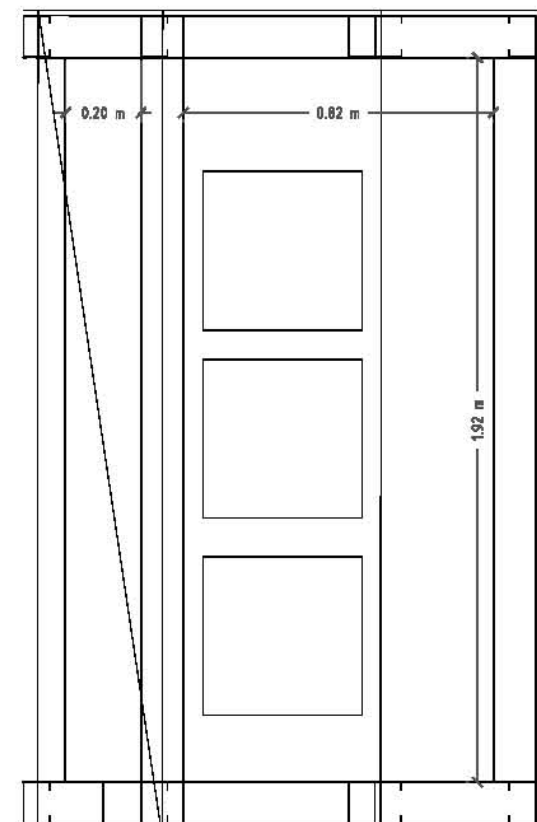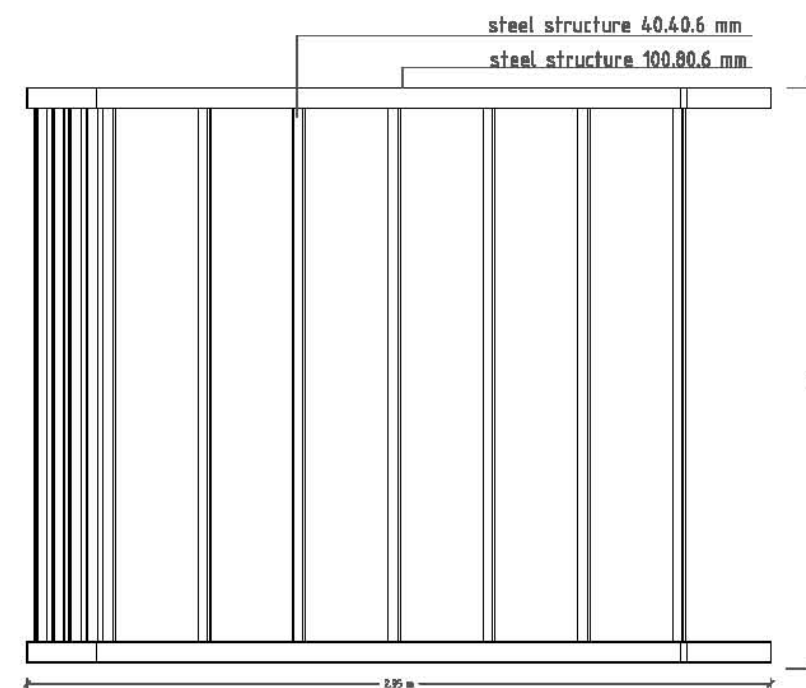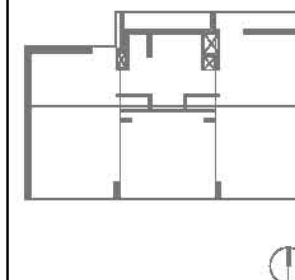

01/7

BC-50

SEVERAL SCALES

SCALE_1:30

SCALE 1 : 20

COORDINATORS	SUPERVISORS	DECATHLETES
--------------	-------------	-------------

MERCEDES PEÑA,
ISABEL MONTAÑÉS
plano designer

CARLOS BERMEJO
design coordinator

MIGUEL GOMEZ
general coordinator

JDE WORCESTER
professional engineer

ALFONSO GARCIA-SANTOS
construction manager

JAVIER NEILA
ARCHITECTURE EDITOR

ESTEFANIA CAAMAÑO

OUTDOORS AREAS



unfolding under the sun
Universidad Politécnica de Madrid (UPM)