




BEDROOM DOOR  
SCALE: 1/20

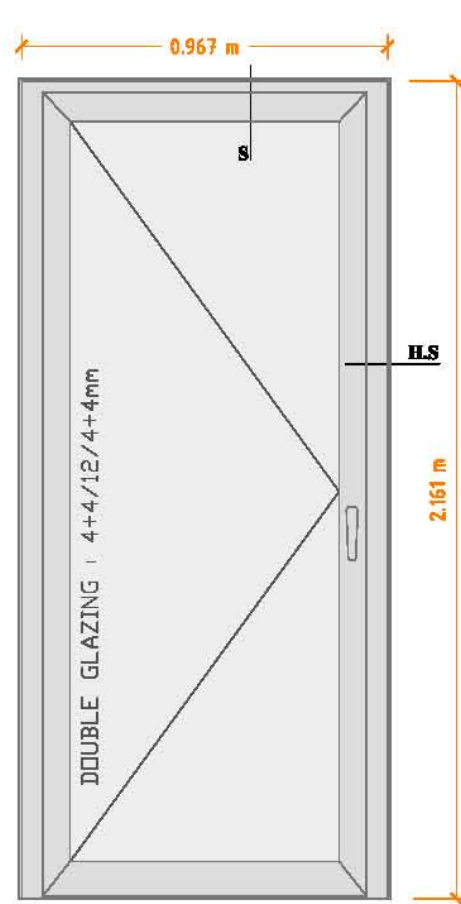



KITCHEN DOOR  
SCALE: 1/20

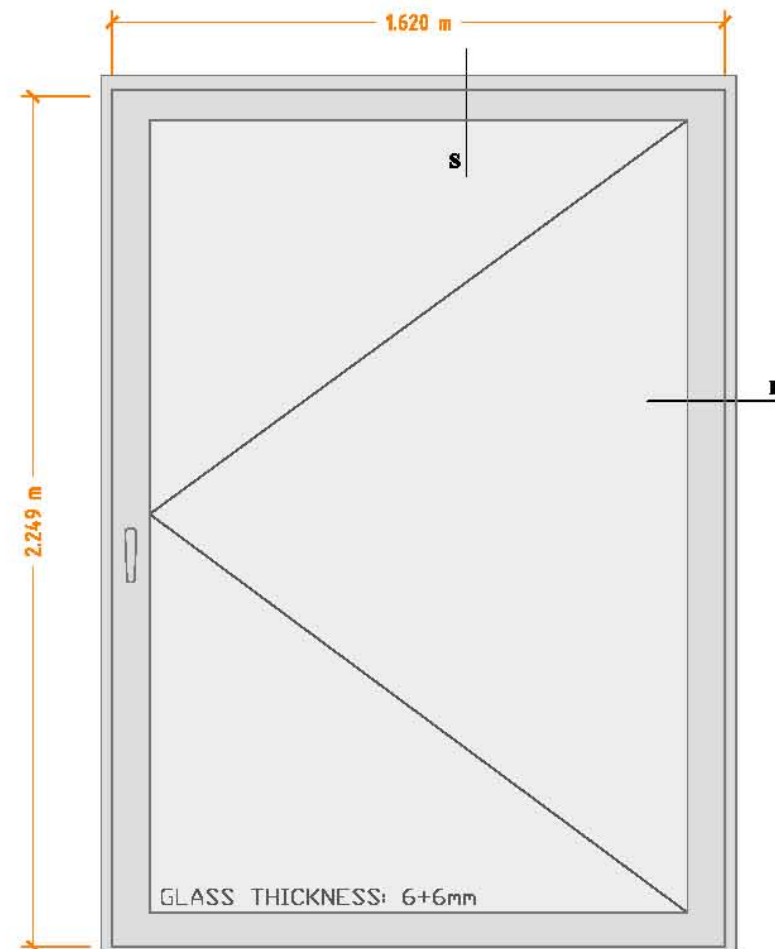

PATIO WEST DOOR  
SCALE: 1/20

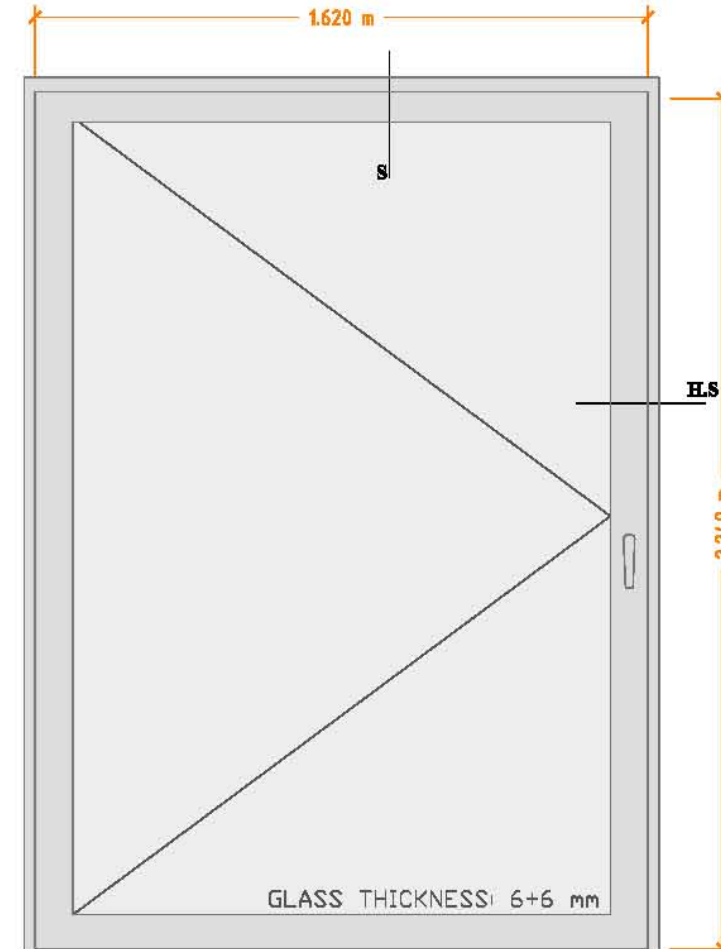

PATIO EAST DOOR  
SCALE: 1/20

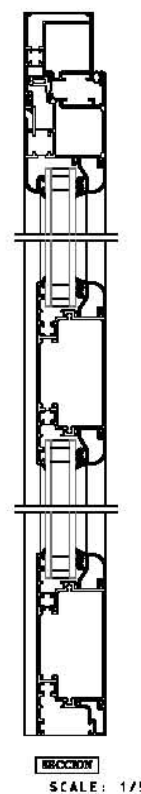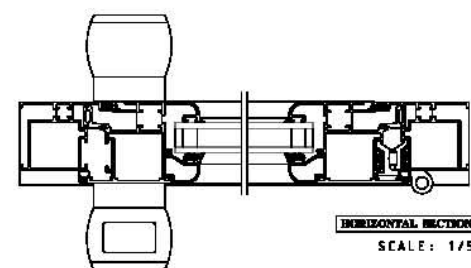

|                                                                                                                                                   |  |                                                                                     |
|---------------------------------------------------------------------------------------------------------------------------------------------------|--|-------------------------------------------------------------------------------------|
|                                                                 |  |  |
| <b>BC - 47</b><br>DATE: 08.04.2005                                                                                                                |  |                                                                                     |
|                                                                |  | <b>BC - 47</b><br>04/07                                                             |
| SEVERAL SCALES<br>1:100<br>1:20<br>1:5                                                                                                            |  | SEVERAL SCALES                                                                      |
| DECAT H L E T S<br>Jose Luis Perez-Griffa<br>plan designer<br>CARLOS BERMEJO<br>design coordinator<br>MIGUEL GOMEZ<br>general coordinator         |  | GLAZING AND FRAMING                                                                 |
| SUPERVISORS<br>ALFONSO GARCIA-SANTOS<br>construction manager<br>JAVIER NEILA<br>architecture manager<br>ESTEFANIA CAAMAÑO<br>general coordinator  |  |                                                                                     |
| COORDINATORS<br>ALFONSO GARCIA-SANTOS<br>construction manager<br>JAVIER NEILA<br>architecture manager<br>ESTEFANIA CAAMAÑO<br>general coordinator |  |                                                                                     |
|                                                              |  |                                                                                     |
| UNFOLDING UNDER THE SUN<br>Universidad Politécnica de Madrid (UPM)                                                                                |  |                                                                                     |