


2005 UPM Madrid

BD - 23

DATE: 08.04.2005

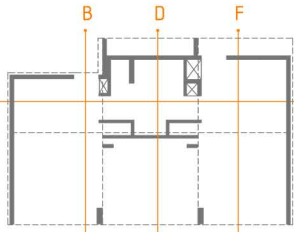

01/01

BD - 23

SCALE_1:100

0 0.5 1 2 3m

0 1 5 10ft

1:100

BIOCLIMATIC PLAN

COORDINATORS SUPERVISORS DECATHLETES

CARLOS BERMEJO
plan designer


CARLOS BERMEJO
design coordinator

MIGUEL GOMEZ
general coordinator

ALFONSO GARCIA-SANTOS
construction manager

JAVIER NEILA
architecture manager

ESTEFANIA CAAMAÑO
general coordinator



magic BOX

unfolding under the sun

Universidad Politécnica de Madrid (UPM)