

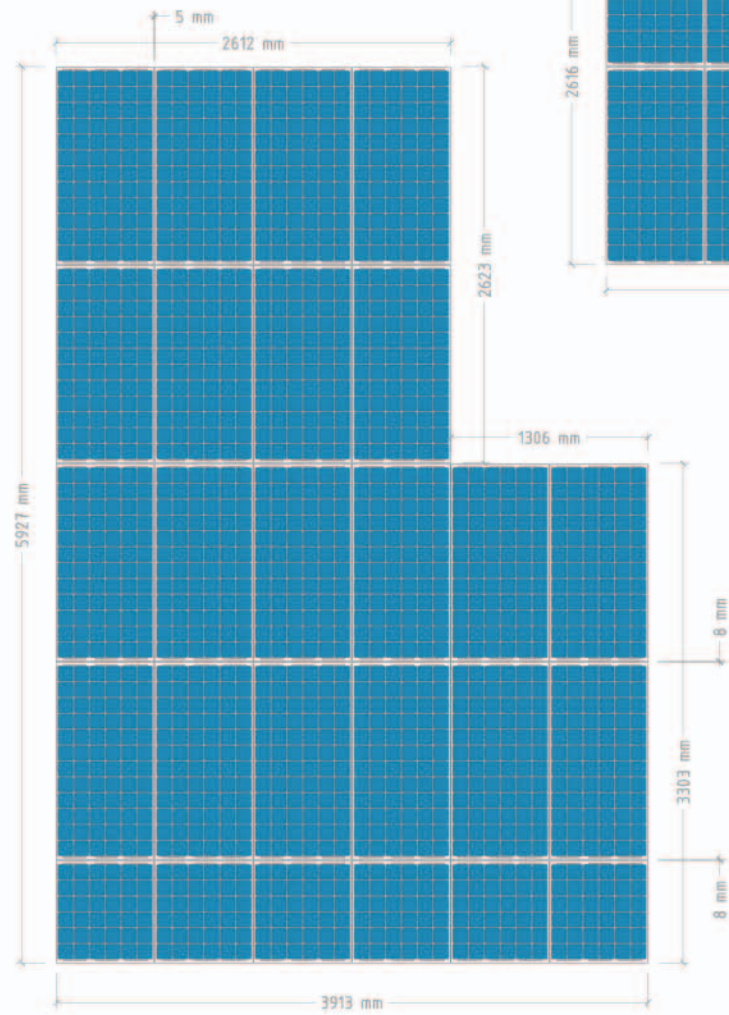


S : 1 / 50

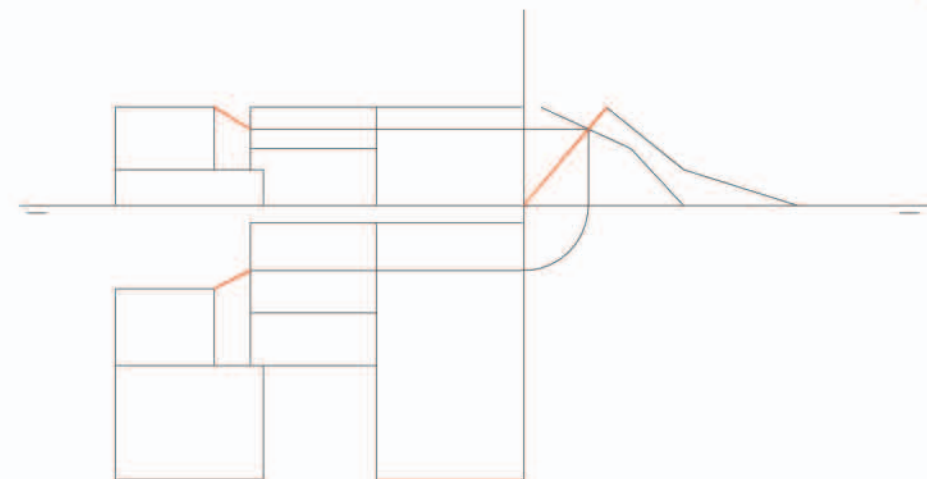

PHOTOVOLTAIC MODULES (PULL-DOWN PLAN)

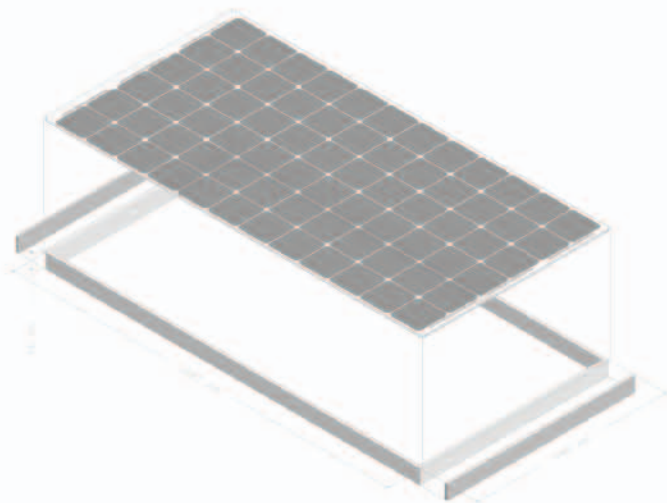


Earliest shade over the Photovoltaic roof.

S : 1 / 10



E - 51

DATE : 08.04.2005

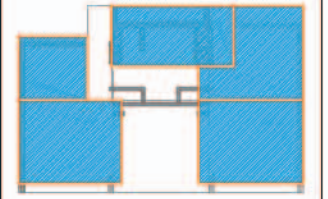

SCALE_1 : 50



DECATHLETES
LUIS CLIMENT
plan designer
CARLOS BERMEJO
design coordinator
MIGUEL GOMEZ
general coordinator



ANTONIO VILLANUEVA
100M industrial engineer

ESTEFANIA CAAMAÑO
general coordinator

JAVIER NEILA
architecture manager

ALFONSO GARCIA-SANTOS
construction manager



03/05

E - 51

1 : 50

PHOTOVOLTAIC SYSTEM MODULATION