


BC - 30

DATE : 08.04.2005



SCALE_1 : 40

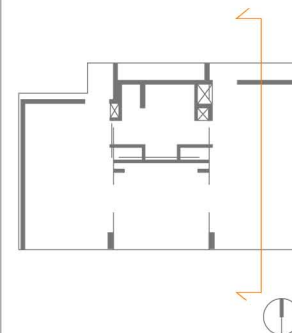

COORDINATOR SUPERVISOR DECAATHLETES

CARLOTREZZO
plan designer

CARLOS BERMEJO
design coordinator

MIGUEL GOMEZ
general coordinator

JOE WORCESTER
professional engineer

ALFONSO GARCIA-SANTOS
construction manager

JAVIER NEILA
architecture manager

ESTEFANIA CAAMAÑO
general coordinator



Universidad Politécnica de Madrid (UPM)

01/01

BC - 30

1 : 40

SECTION E : BEDROOM+OFFICE