

FURNITURE FINISH



MÉTODO NUZZI kitchen furniture.
(ISO 9001 and ISO 9002 regulations and the AENOR Quality System Certificate).

- Finish: stainless steel.
- 01 -Countertop: silestone in red, 3 mm. thick.
- 02 -Cabinet doors: laminated wood, stainless steel finish. Furniture finish matches appliances.
- Handles: stainless steel.
- 03 -Rolling blind 550 mm. large. Stainless steel finish.

TEKA BE 34.45 stainless steel sink, 335x452 mm.
TEKA MX Chrome 41022001 kitchen tap.



- SIEMENS APPLIANCES ***
- a 0 1 REFRIGERATOR AND FREEZER.
KS 45 U 640 (inoxlook).
Interior capacity: 0,434 m3.
Dimensions: 170x70x74 cm.
 - a 0 2 DISHWASHER.
SF 25 T 053 EU (stainless steel).
Capacity: 9 servings.
Dimensions: 85x45x60 cm.
 - a 0 3 OVEN + MICROWAVE (+innowave)
HB 84 K 550 (stainless steel).
Dimensions: 45,4x59,5x53,1 cm.
 - a 0 4 RANGE.
EH 515502 E (stainless steel).
2 cooktops (induction).
Dimensions: 28,8x51,6 cm.
 - a 0 5 HOOD.
LC 57750 (stainless steel hood with flat glass canopy and aluminum trim).
Re-circulated air: 76,6x70x52 cm.

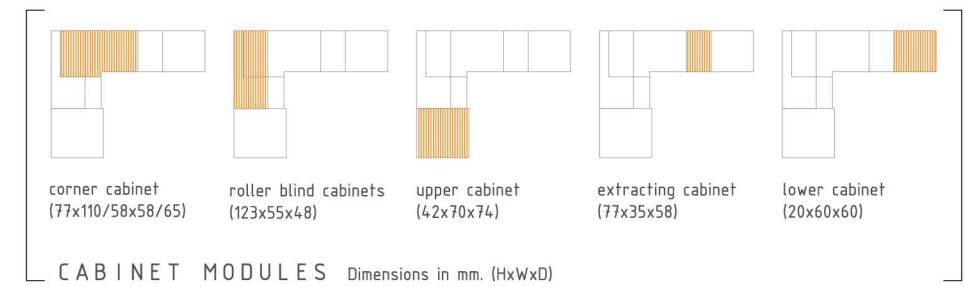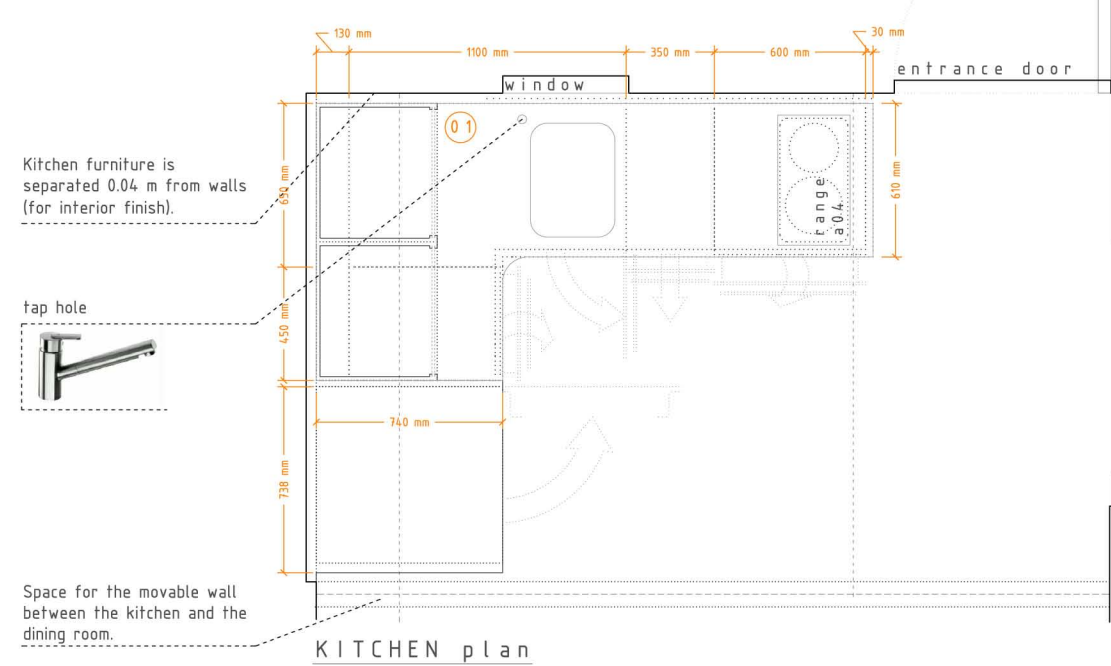

2005 SOLAR DECATHLON

BC - 4 1

DATE: 08.04.2005

01/01

SCALE 1:30

0 0.5 1m

0 1 2 3ft

1:30

COORDINATORS SUPERVISORS DECATHLETES

SOFIA MELERO
GONZALO USED
plan designers

CARLOS BERMEJO
design coordinator

MIGUEL GOMEZ
general coordinator

ALFONSO GARCIA-SANTOS
construction manager

JAVIER NEILA
architecture manager

ESTEFANIA CAAMAÑO
general coordinator

KITCHEN FURNITURE

unfolding under the sun

Universidad Politécnica de Madrid (UPM)

* SIEMENS appliances (more details: E-54).