
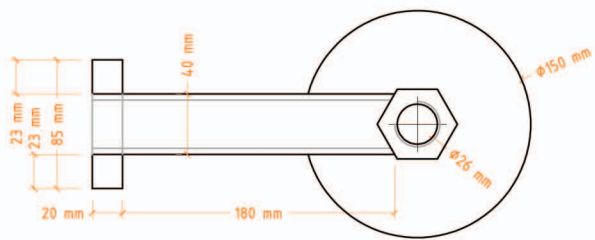
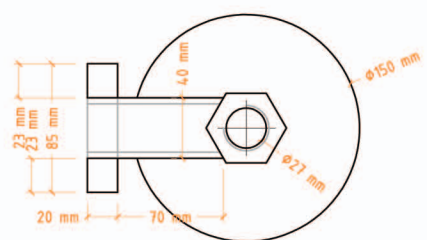
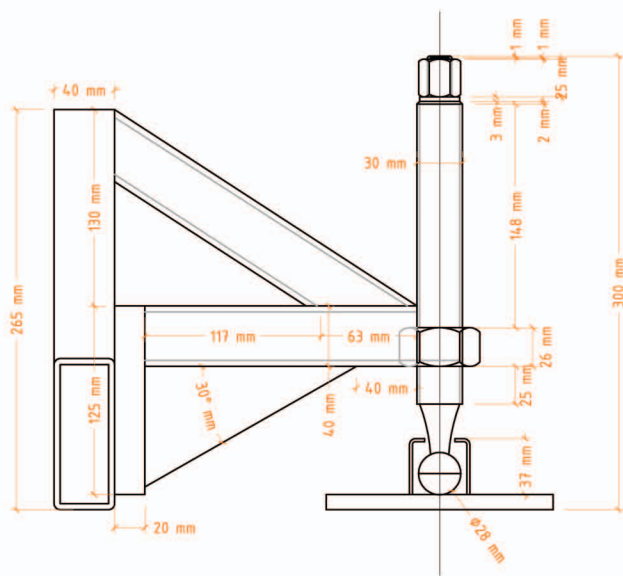





GROUND FLOOR STRUCTURE DETAILS

Detail 3- Foundation piece detail.

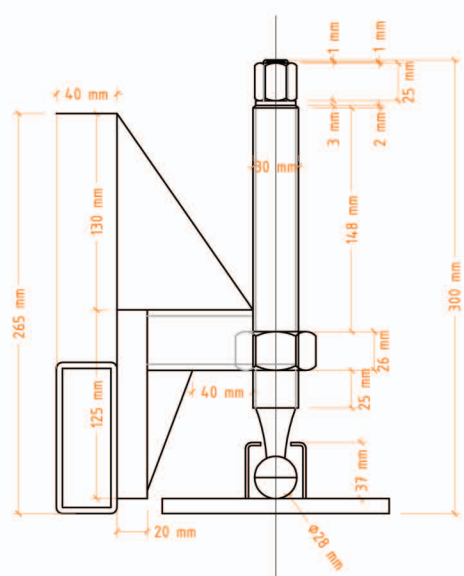


E : 1 / 10

Detail 2- structural floor border detail.

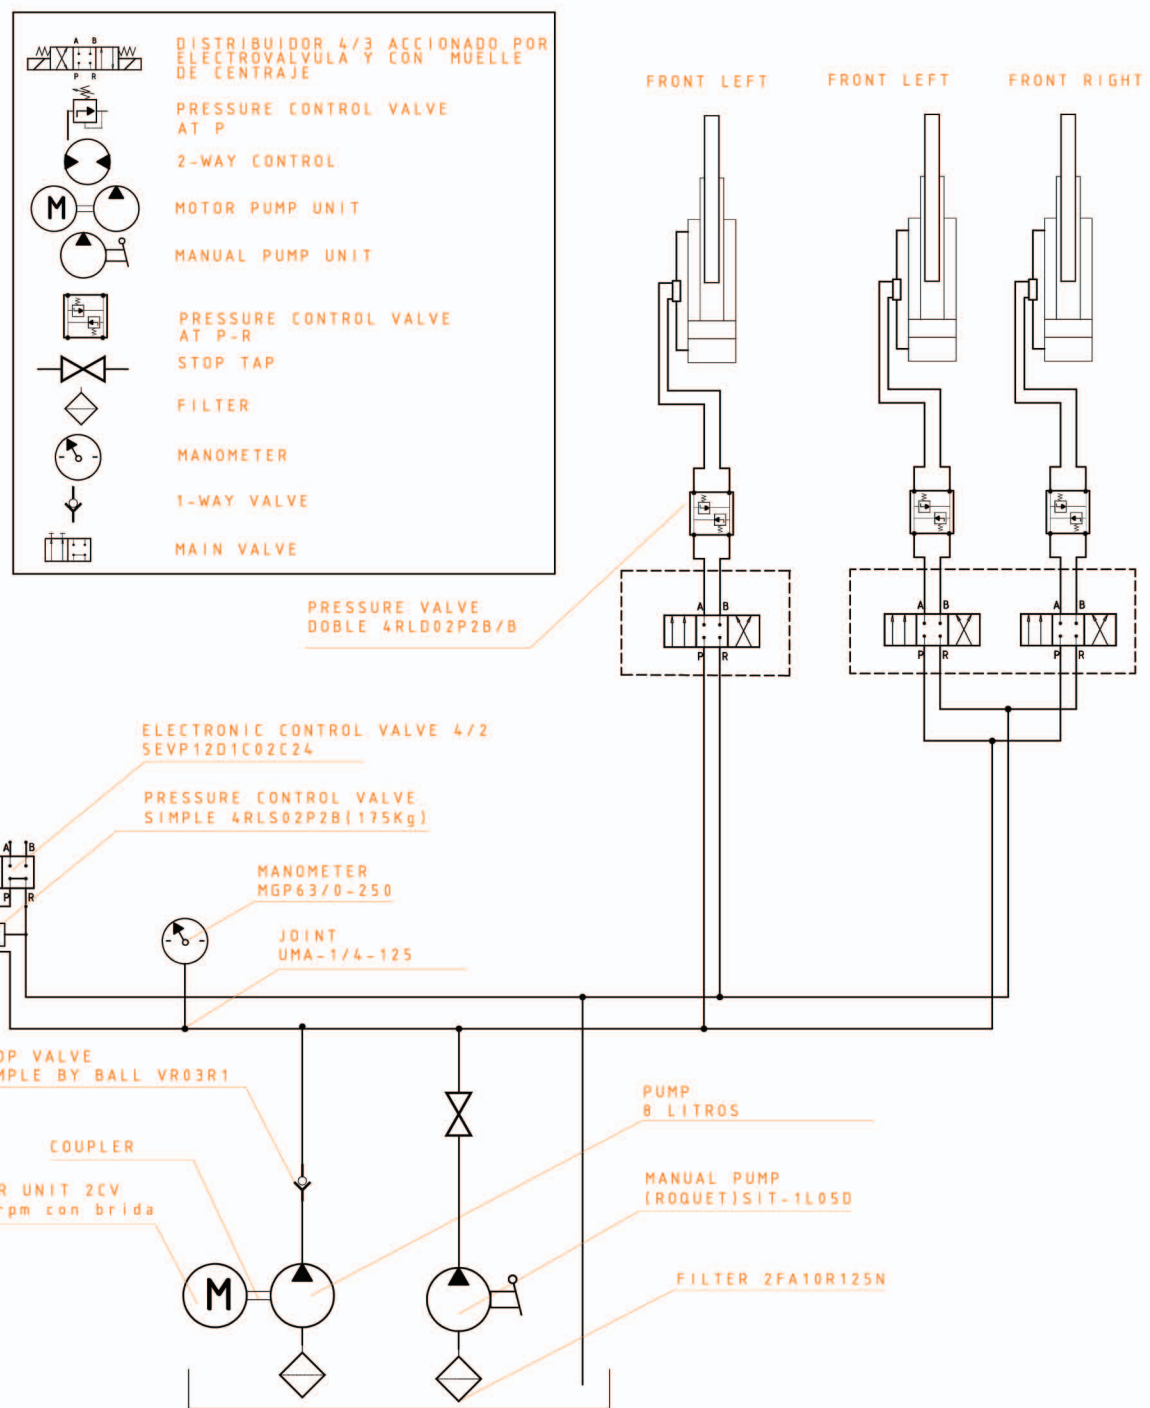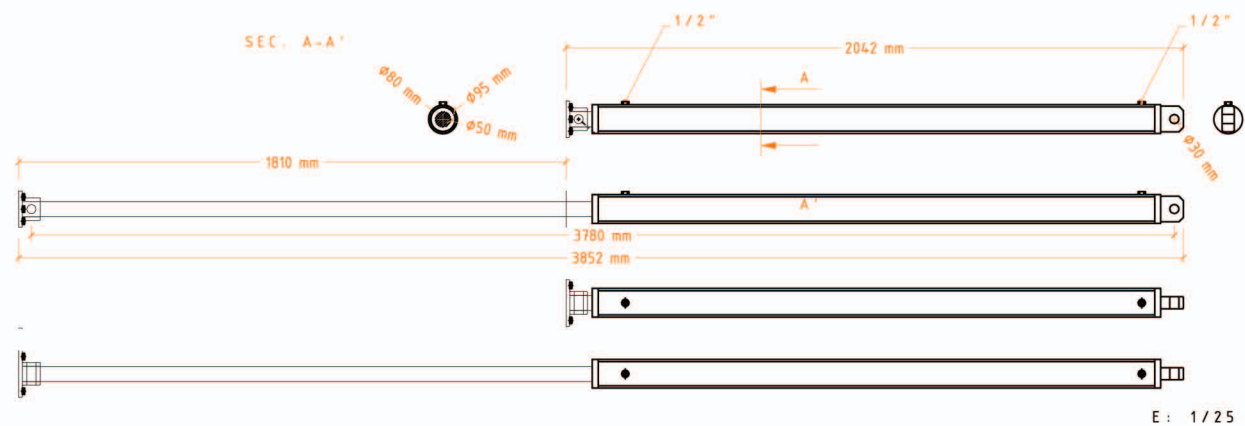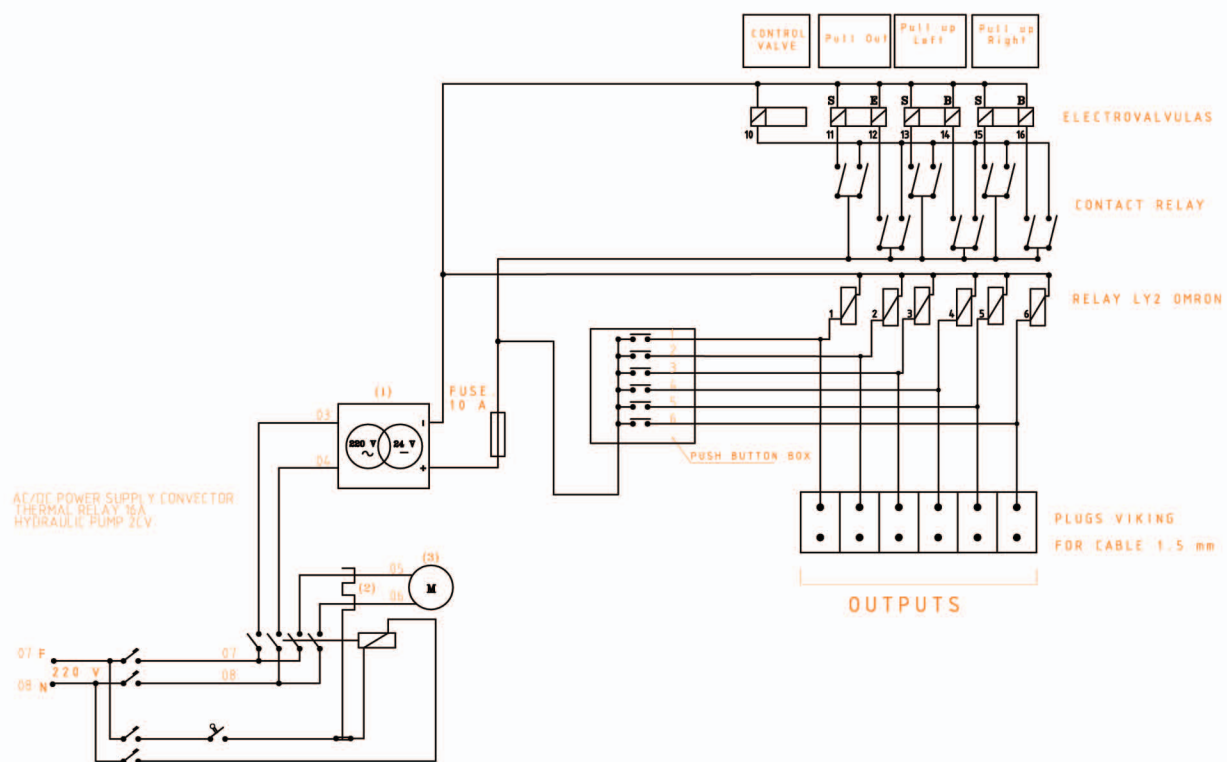

S - 19

DATE: 08.04.2005

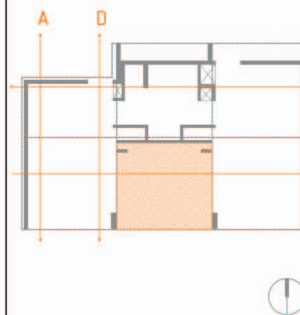

SCALE_1:30

TES
JOAQUIN HIDALGO
place des...

CARLOS BERMEJO
design coordinator

MIGUEL GOMEZ
general coordinator

JOE WORCESTER
professional engineer

ALFONSO GARCIA-SANTOS
construction manager

JAVIER NEILA
architecture manager

ESTEFANIA CAAMAÑO
general coordinator



06/06

S-19

1:30

MOVABLE MODULE - COMPONENTS