


KITCHEN AREA




SLOPED ROOF DETAIL

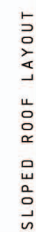

SLOPED ROOF LAYOUT




SLOPED ROOF

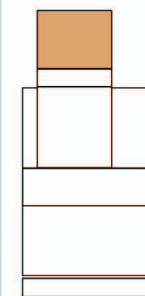

SLOPED ROOF LAYOUT


STEEL FRAME ELEMENTS (G)

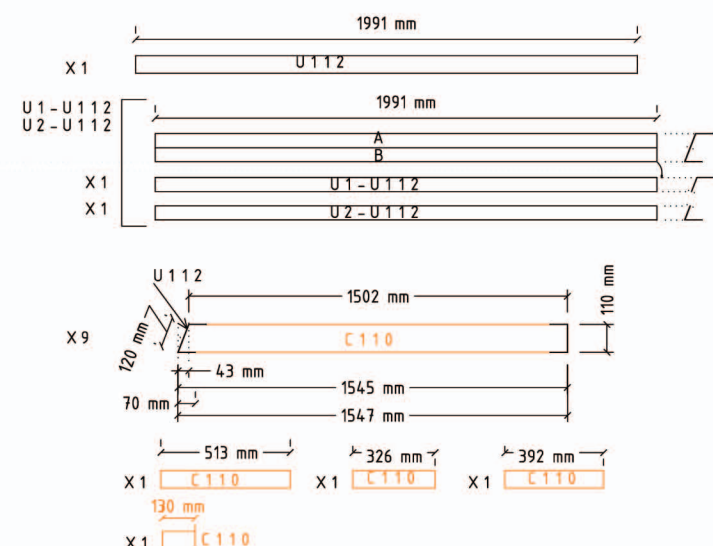

DATE: 08.04.2005



SCALE_1:30

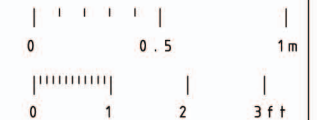

SUPERVISORS DECATHELES

LETICIA RO-BER
plan designer

CARLOS BERMEJO
design coordinator

MIGUEL GOMEZ
general coordinator

COORDINATORS

JOE WORCESTER
professional engineer

ALFONSO GARCÍA-SANTOS
construction manager

JAVIER NEILA
architecture manager

ESTEFANÍA CAAMAÑO
general coordinator



unfolding under the sun
Universidad Politécnica de Madrid (UPM)

03/11

S-22

1:30

STEEL FRAMING: ROOF LAYOUT