


UPM 2005

A - 09

DATE: 08.04.2005

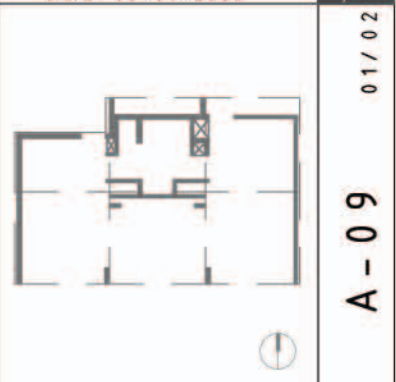

01/02

A - 09

SCALE_1:50

0 0.5 1m

0 1 2 3ft

1:50

DECATHLETES

LUIS CLIMENT
plan designer

CARLOS BERMEJO
design coordinator

MIGUEL GOMEZ
general coordinator

SUPERVISORS


COORDINATORS

ESTEFANIA CAAMAÑO
general coordinator

JAVIER NEILA
architecture manager

ALFONSO GARCIA-SANTOS
construction manager

ROOF - FOLDED POSITION



magic BOX

extending urban life

Universidad Politécnica de Madrid (UPM)