



PUSH-FIT system PB. (polybutilene)
Plumbing assembly is made with PB straight
flexibles pipes and PB parts.

NUEVA TERRAIN MODELS AND DIMENSIONS. PB PARTS.

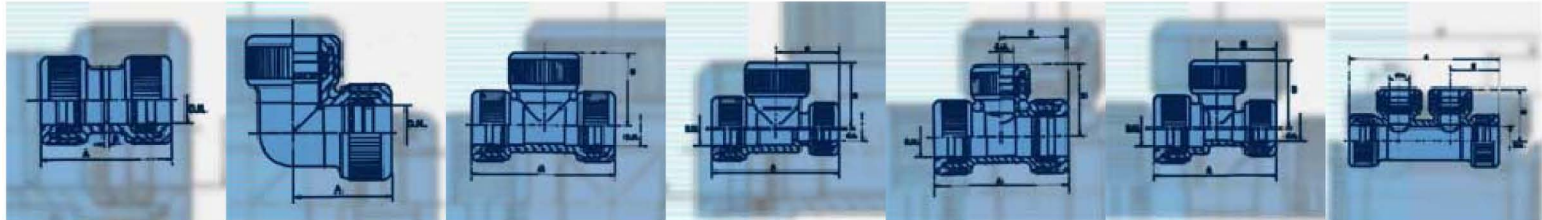

STRAIGHT CONNECTOR 90° ELBOW 90° EQUAL TEE 90° END REDUCED TEE 90° END REDUCED TEE 90° END REDUCED TEE 90° END REDUCED TEE TWO PORT MANIFOLD

RANGE AND DIMENSIONS. TRANSITION PARTS.

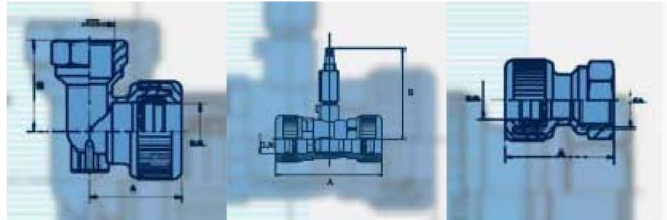


90° FEMALE SOCKET ADAPTER ELBOW BALL VALVE CASING MALE METAL STRAIGHT CONNECTOR




P - 55

DATE : 08.04.2005

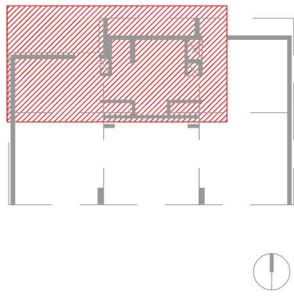

SCALE_1:25

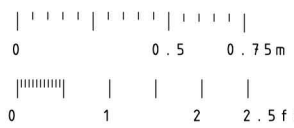

SOFIA MELERO
GONZALO USED
plan designer

CARLOS BERMEJO
design coordinator

MIGUEL GOMEZ
general coordinator



ANTONIO VILLANUEVA
IDOM/professional supervisor

ALFONSO GARCIA-SANTOS
construction manager

JAVIER NEILA
architecture manager

ESTEFANIA CAAMAÑO
general coordinator



Universidad Politécnica de Madrid (UPM)

03/07

P - 55

1:25

PLUMBING DRAWINGS. DHW.