

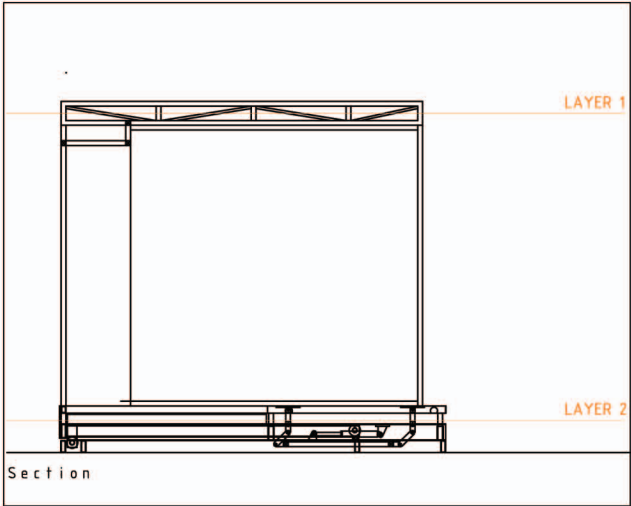



FIRST ROOF LAYER

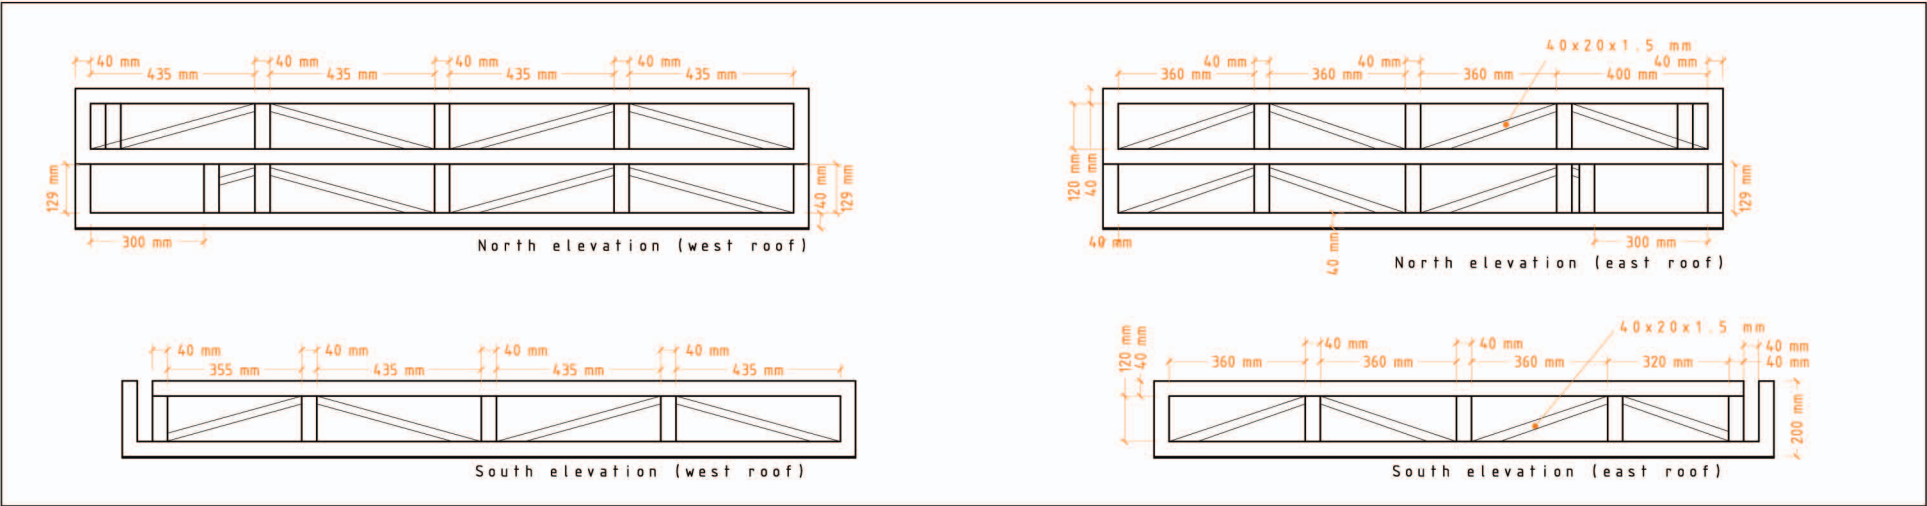


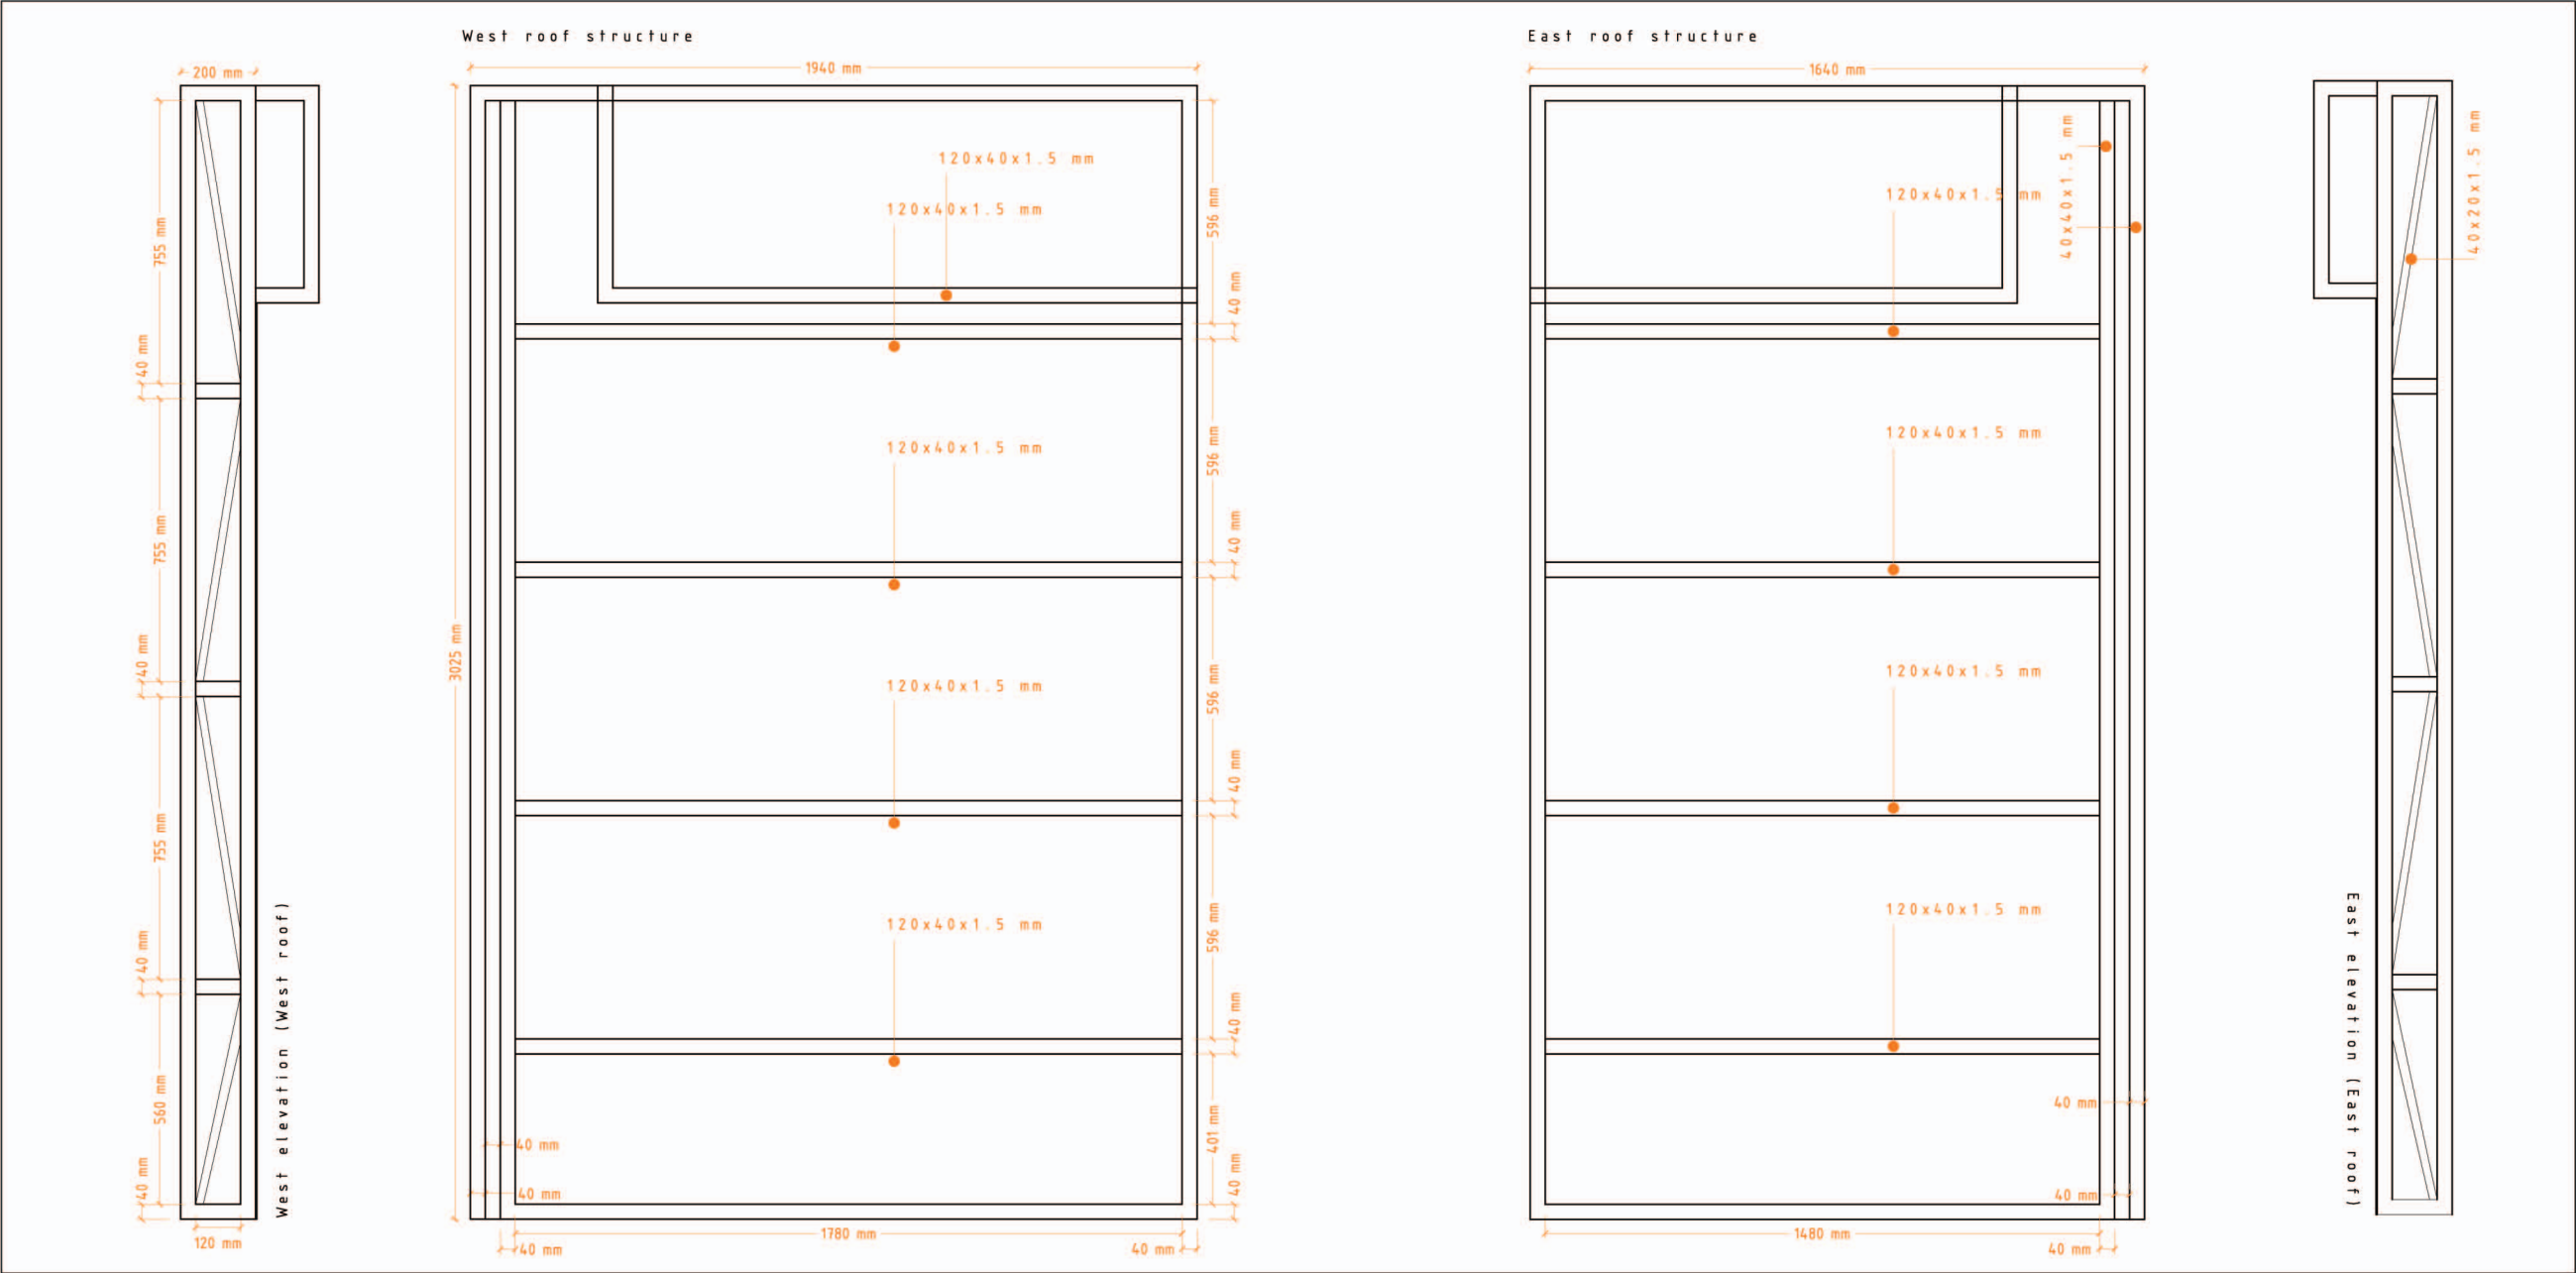

SOLAR DECATHLON 2005 UPM Madrid

S - 19

DATE: 08.04.2005

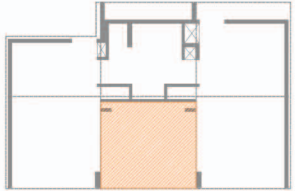

S - 19

05/06

SCALE\_1:30

0 0.5 1m

0 1 2 3ft

1:30

COORDINATORS

JOAQUIN HIDALGO  
plan designer

CARLOS BERMEJO  
design coordinator

MIGUEL GOMEZ  
general coordinator

SUPERVISORS

JOE WORCESTER  
professional engineer


CONSTRUCTORS

ALFONSO GARCIA-SANTOS  
construction manager

JAVIER NEILA  
architecture manager

ESTEFANIA CAAMAÑO  
general coordinator

MOVABLE MODULE



magic BOX

unfolding under the sun

Universidad Politécnica de Madrid (UPM)