


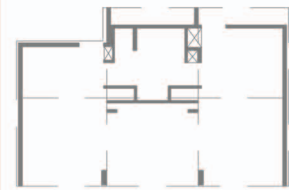
CONVOCATORIA 2005 UPM

FCA-02

DATE: 08.04.2005




02/02



FCA-02

SCALE 1:40

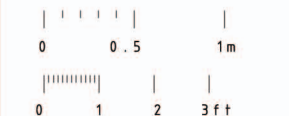

1:40

COORDINATORS SUPERVISORS DE CATHLETES

HELDER J. MARTINS
plan designer

CARLOS BERMEJO
design coordinator

MIGUEL GOMEZ
general coordinator


COORDINATORS SUPERVISORS

ALFONSO GARCIA-SANTOS
construction manager

JAVIER NEILA
architecture manager

ESTEFANIA CAAMAÑO
general coordinator

FOOTPRINT UNFOLDED LAYOUT



unfolding under the sun

Universidad Politécnica de Madrid (UPM)