



DETAIL 5

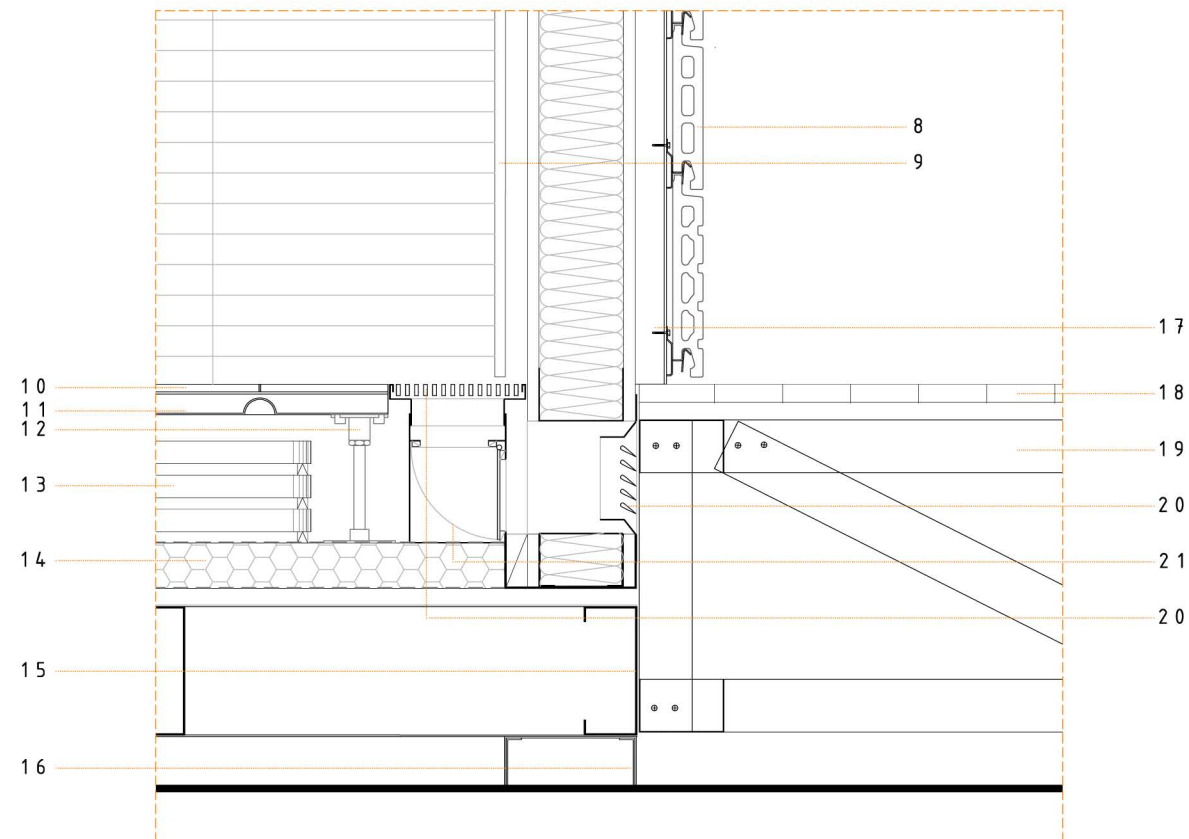

DETAIL 6

LEGEND


- 01. TRUSS
- 02. ANTI DRIFT SHEET
- 03. PVC WATERPROOFING
- 04. 112.70.1mm U-SHAPED STEEL JOIST
- 05. 16mm-THICK OSB
- 06. T-PLUS GALVANIZED-STEEL PLATE
- 07. CLAY TILES FIXING CLIP
- 08. CLAY TILE
- 09. 12mm-THICK DM CLICKBOARD
- 10. 600x300mm CERAMIC TILE
- 11. 600x600mm CAST IRON BASE
- 12. FLOOR PLOT
- 13. CHANGE-OF-PHASE GEL CAPSULES
- 14. 60mm-THICK WOOD-FIBER INSULATION
- 15. 170.70.20.2mm C-SHAPED STEEL JOIST
- 16. FOOTING: C-SHAPED STEEL JOIST 170.70.20.2mm + U-SHAPED STEEL JOIST 170.70.2mm
- 17. OMEGA-SHAPED FRAME 40.60.1mm
- 18. WOODEN CLADDING
- 19. DECK STRUCTURE (112.70.1mm U-SHAPED STEEL JOIST)
- 20. ALUMINUM VENTILATION GRATE
- 21. STEEL TRAPDOOR (AUTOMATED CONTROL SYSTEM)

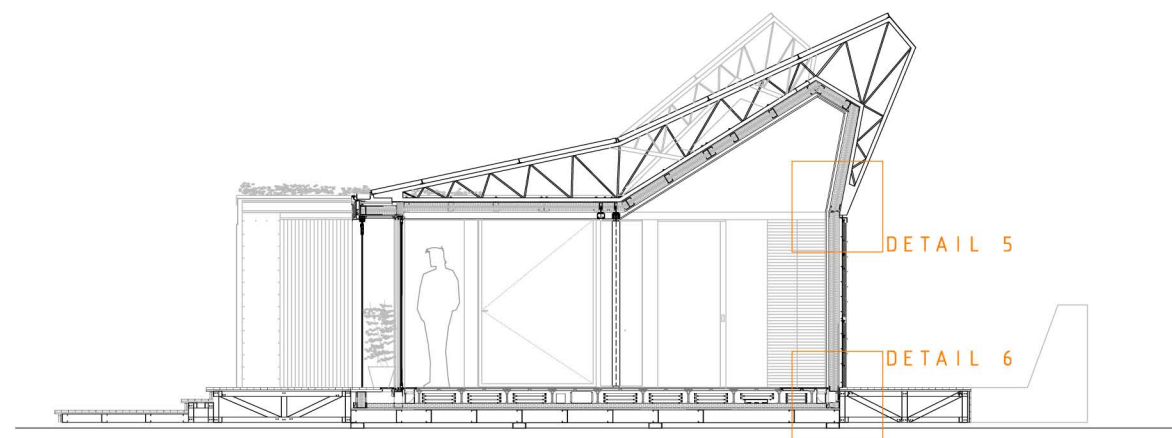


SCALE 1:100

BC - 34

DATE: 08.04.2005

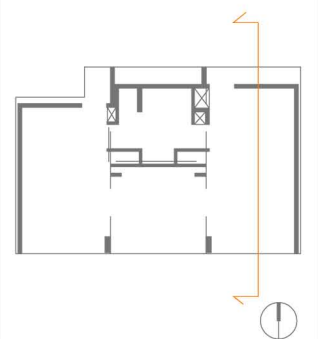

SCALE_1:10

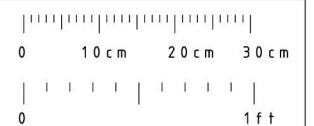

03/04

BC - 34

1:10

RAFAEL PALOMARES
CARLOTREZZO
plan designer

CARLOS BERMEJO
design coordinator

MIGUEL GOMEZ
general coordinator

JOE WORCESTER
professional engineer

ALFONSO GARCIA-SANTOS
construction manager

JAVIER NEILA
architecture manager

ESTEFANIA CAAMAÑO
general coordinator

CONSTRUCTION DETAILS