

A - 07


DATE: 08.04.2005



01/02

A - 07

SCALE 1:40

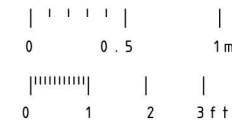

1:40

COORDINATORS SUPERVISORS DECATHLETES

RAFAEL PALOMARES  
plan designer

CARLOS BERMEJO  
design coordinator

MIGUEL GOMEZ  
general coordinator

ALFONSO GARCIA-SANTOS  
construction manager

JAVIER NEILA  
architecture manager

ESTEFANIA CAAMAÑO  
general coordinator

MAIN PLAN. FOLDED POSITION



unfolding under the sun  
Universidad Politécnica de Madrid (UPM)