



## MODEL OF CONTAINER

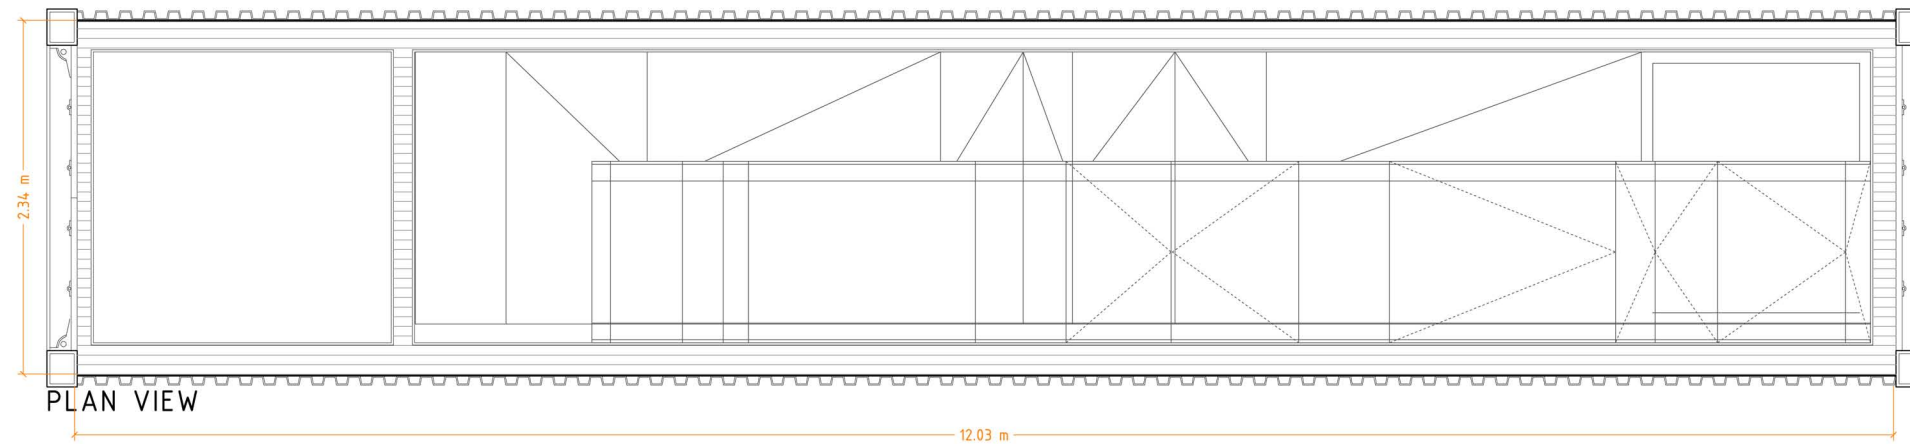


PLAN VIEW

12.03 m

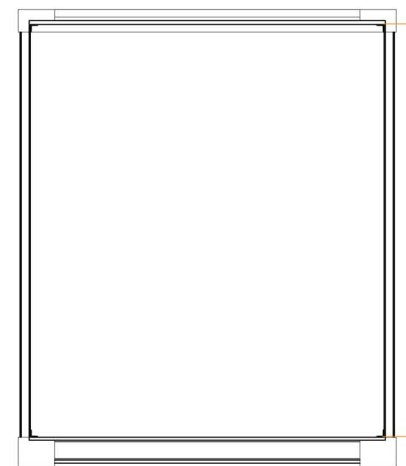

CROSS SECTION

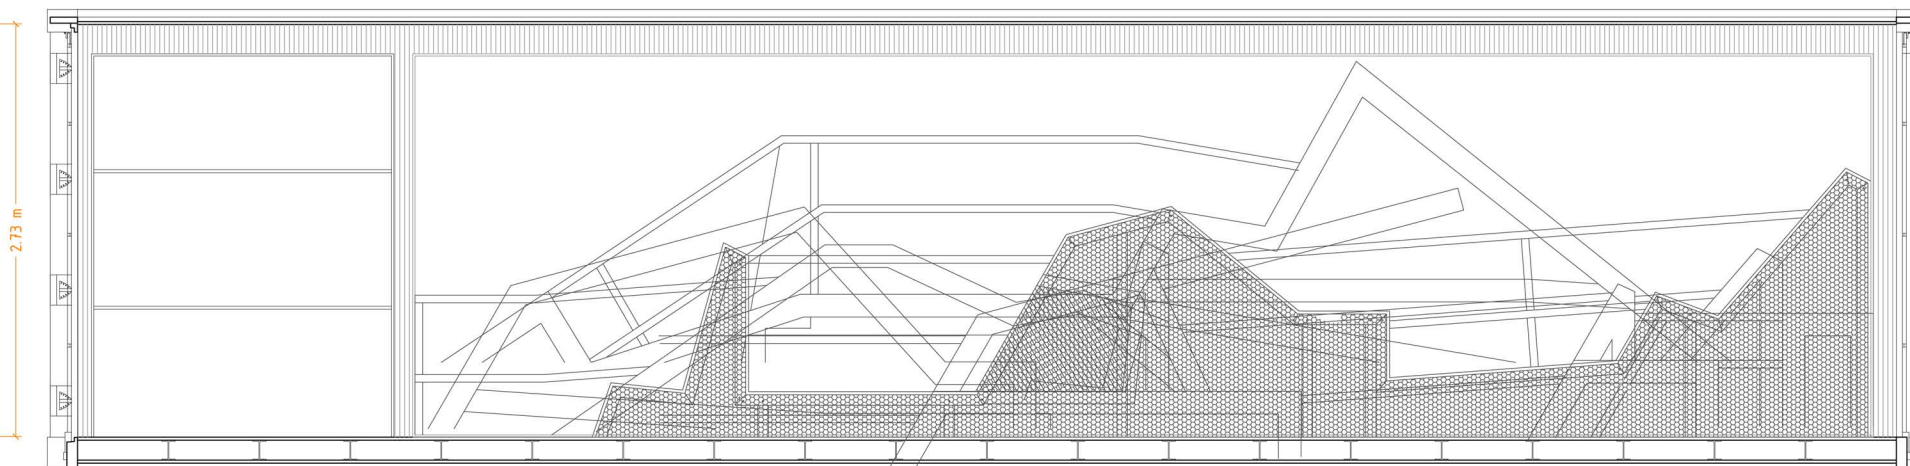


LONGITUDINAL SECTION

2.73 m




## AUXILIAR STRUCTURE FOR WALLS PACKING AND TRANSPORTATION

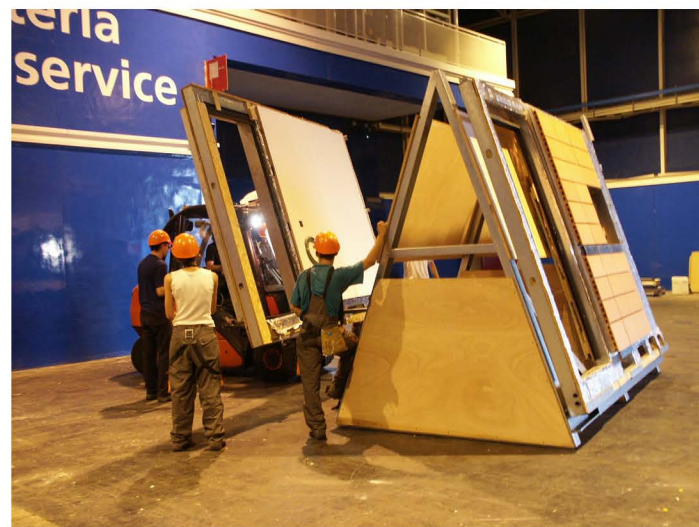

AD-60


DATE: 08.04.2005

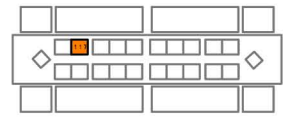

01 / 01

AD - 60

SCALE\_1:50

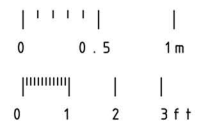

1:50

IVÁN ALCANTARILLA  
plan designer

CARLOS BERMEJO  
design coordinator

MIGUEL GOMEZ  
general coordinator

ALFONSO GARCIA-SANTOS  
construction manager

JAVIER NEILA  
architecture manager

ESTEFANIA CAAMAÑO  
general coordinator

PACKING

