




AREA 2 OSB SLOPED ROOF PANELS (BATHROOM LAYOUT)

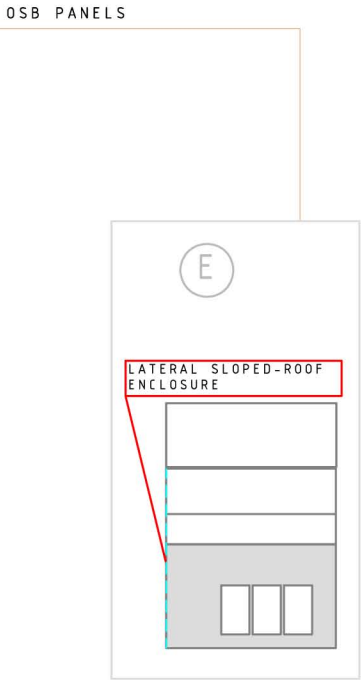

OSB ROOF PANELS (D)

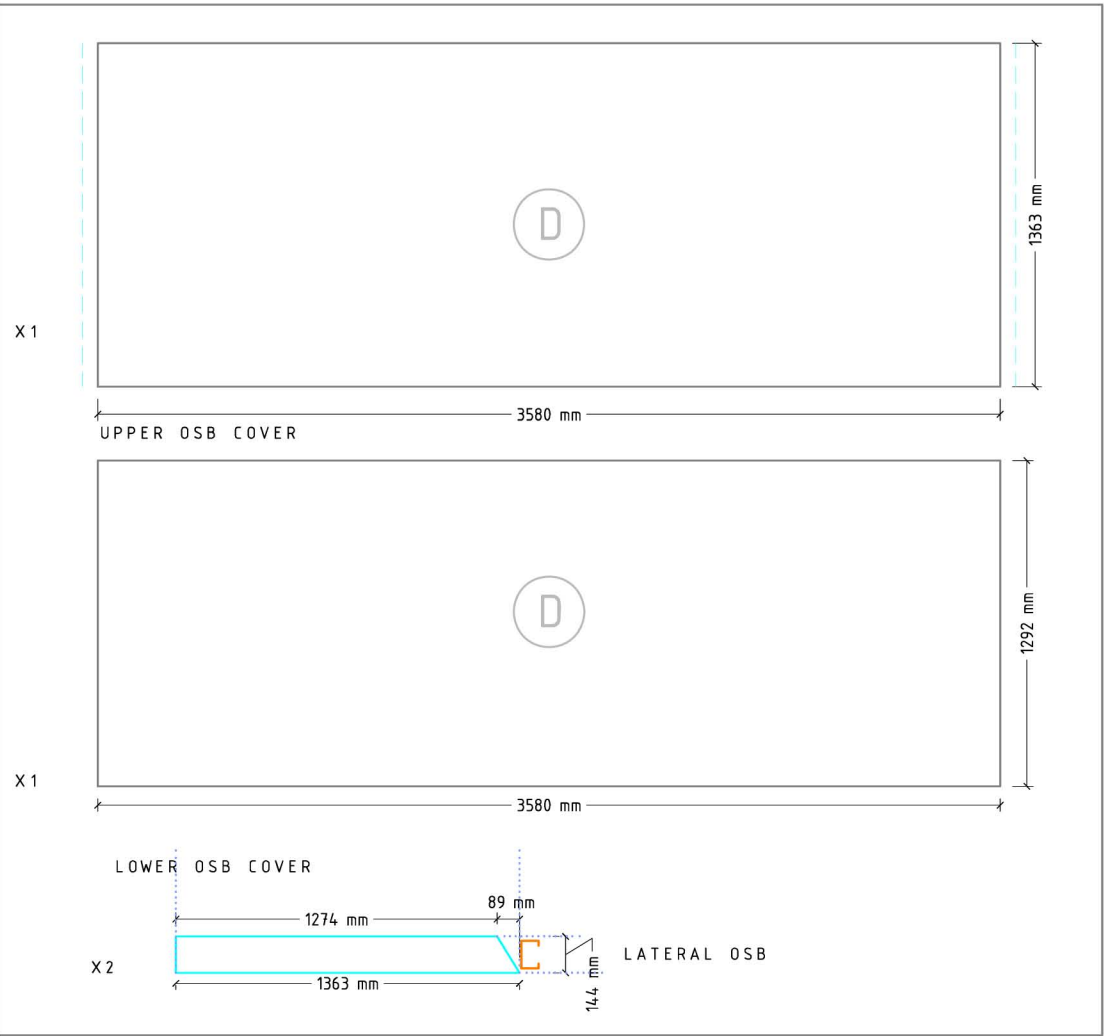


OSB ROOF PANELS (E)

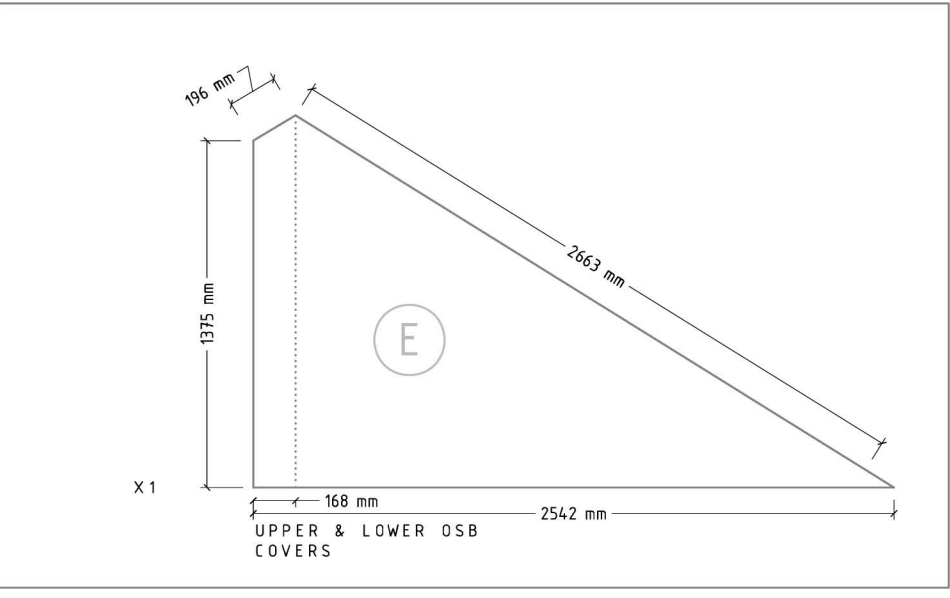

S - 2 2

DATE : 08.04.2005

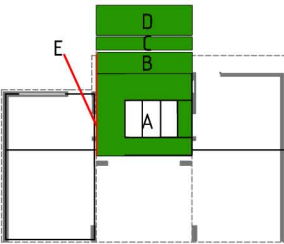

SCALE\_1:30



LETICIA RO-BER  
plan designer  
CARLOS BERMEJO  
design coordinator  
MIGUEL GOMEZ  
general coordinator

JOE WORCESTER  
professional engineer

ALFONSO GARCÍA-SANTOS  
construction manager

JAVIER NEILA  
architecture manager

ESTEFANÍA CAAMAÑO  
general coordinator



Universidad Politécnica de Madrid (UPM)

08/10

S - 2 2

1:30

OSB PANELS: ROOF LAYOUT