


Levels:
Wall top edge +3.07m
Clay tiles top edge +3.00m
Steel framing top edges +2.81m
Suspended ceiling +2.77m

OSB Panels

Oriented Strand Boards
2500x1250x15mm

Floor +0.53m
Steel framing bottom edge +0.27m
Ground level +0.00m

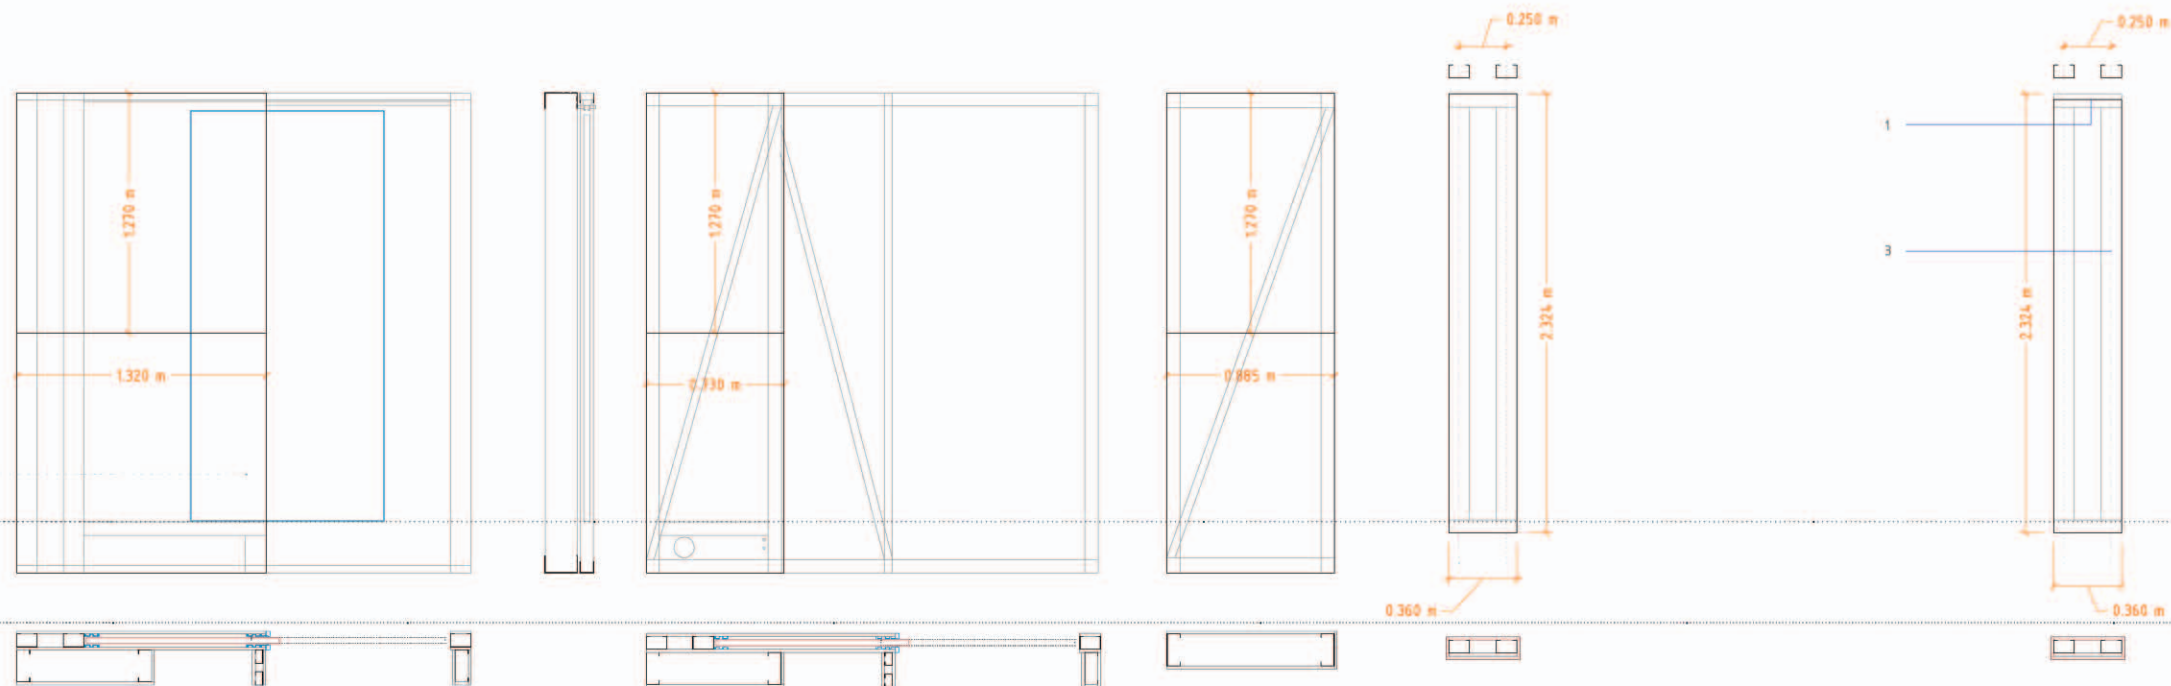


Levels:
Wall top edge +3.07m
Clay tiles top edge +3.00m
Steel framing top edges +2.81m
Suspended ceiling +2.77m

Steel framing

Galvanized steel C-shaped profile: 110x70x20x1mm.
Galvanized steel U-shaped profile: 114x70x1mm.

Floor +0.53m
Steel framing bottom edge +0.27m
Ground level +0.00m

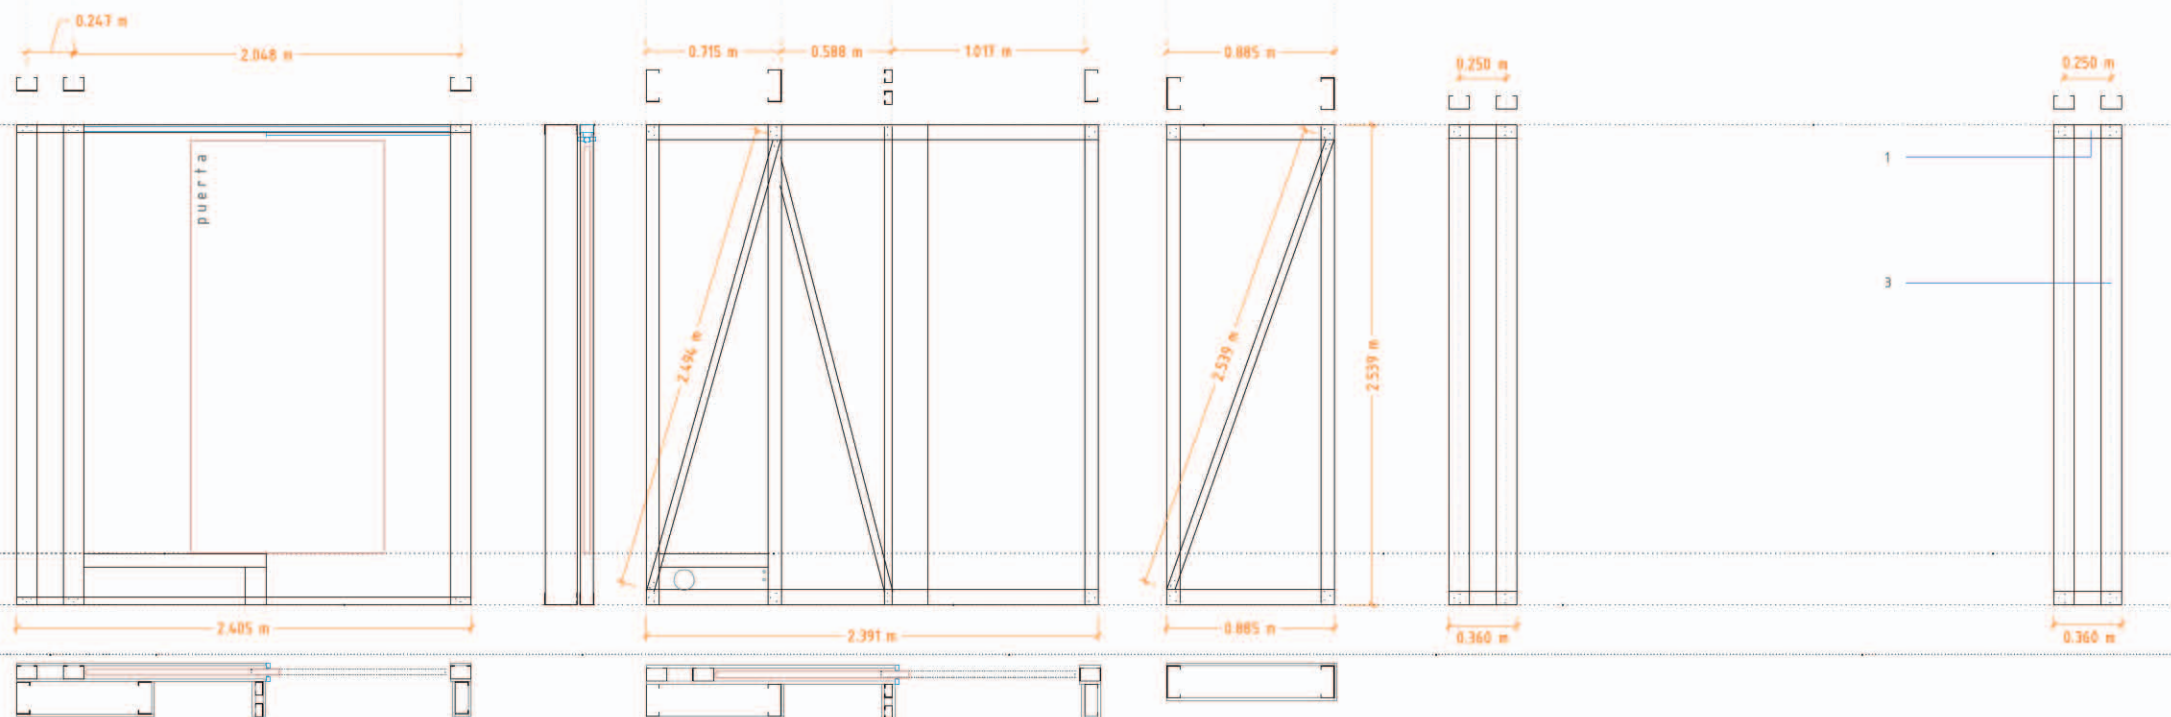

Load-bearing wall 0'1/O'2


Load-bearing wall U

Load-bearing wall S




S - 20

DATE: 08.04.2005

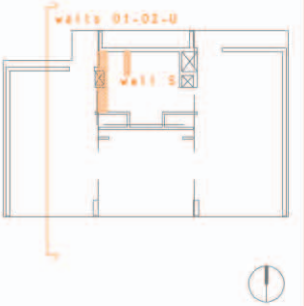

SCALE_1:40

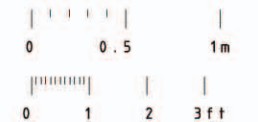

COORDINATORS SUPERVISORS DE CATHLETES

DANIEL CARDOSO
plan designer

CARLOS BERMEJO
design coordinator

MIGUEL GOMEZ
general coordinator

JOE WORCESTER
professional engineer

ALFONSO GARCIA-SANTOS
construction manager

JAVIER NEILA
architecture manager

ESTEFANIA CAAMAÑO
general coordinator



Intelling under the sun
Universidad Politécnica de Madrid (UPM)

07/07

S - 20

1:40

MAIN STRUCTURE: INT. WALLS 2