


2005

BC - 39

DATE: 08.04.2005

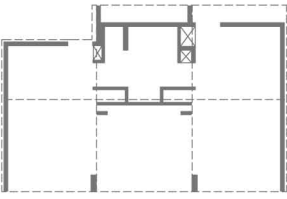

03/03

SCALE_1:40

0 0.5 1m

0 1 2 3ft

DECATHLETES

RAFAEL PALOMARES
plan designer

CARLOS BERMEJO
design coordinator

MIGUEL GOMEZ
general coordinator

COORDINATORS

ALFONSO GARCIA-SANTOS
construction manager

JAVIER NEILA
architecture manager

ESTEFANIA CAAMAÑO
general coordinator

CEILING PANELS

magic BOX

unfolding under the sun

Universidad Politécnica de Madrid (UPM)