




CONDITIONED AREA - UNFOLDED LAYOUT 51.42 m<sup>2</sup>




**FCA-03**  
DATE: 08.04.2005



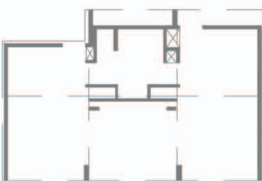

**FCA-03** 02/02

SCALE\_1:40

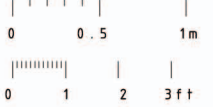

1:40

COORDINATORS SUPERVISORS DE CATHLETES

**HELDER J. MARTINS**  
plan designer

**CARLOS BERMEJO**  
design coordinator

**MIGUEL GOMEZ**  
general coordinator

COORDINATORS SUPERVISORS DE CATHLETES

**ALFONSO GARCIA-SANTOS**  
construction manager

**JAVIER NEILA**  
architecture manager

**ESTEFANIA CAAMAÑO**  
general coordinator

**magic BOX**  
expanding under the sun  
Universidad Politécnica de Madrid (UPM)