


SYMBOLS

- CERAMIC FLOOR TILE
- VENTILATION GRILLE
- ORIENTED STRAND BOARD FLOOR
- CERAMIC JOINT
- MANUFACTURED STONE
- CUMARU (WOODEN CLADDING)
- PLATE
- WHITE FELDSPAR STONES



BC - 37

DATE : 08.04.2005

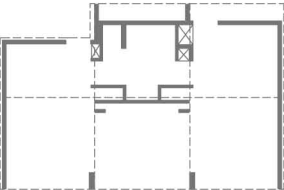

SCALE_1:40



DECATHLETES

RAFAEL PALOMARES
plan designer

CARLOS BERMEJO
design coordinator

MIGUEL GOMEZ
general coordinator

COORDINATORS

ALFONSO GARCIA-SANTOS
construction manager

JAVIER NEILA
architecture manager

ESTEFANIA CAAMAÑO
general coordinator



unfolding under the sun
Universidad Politécnica de Madrid (UPM)

01/01

BC - 37

1:40

FLOOR FINISH