



SECTION G

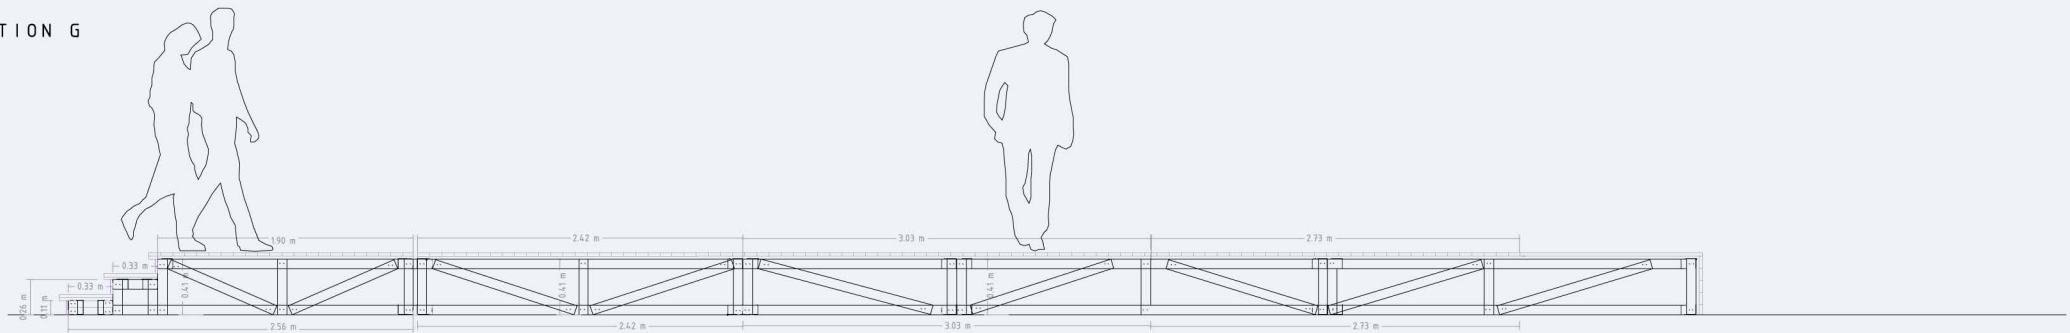

TOP

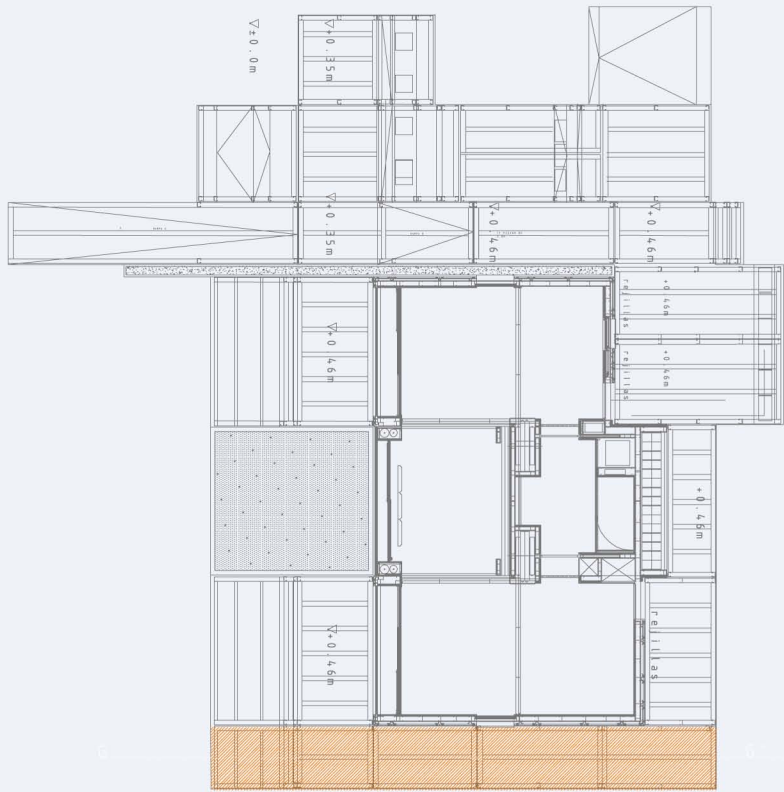

STRUCTURE _____ STEEL BUILT

WOODEN STRIPS


WOODEN
SECONDARY STRUCTURE

CLIP

Ø 110


Ø 112

SCALE 1:5

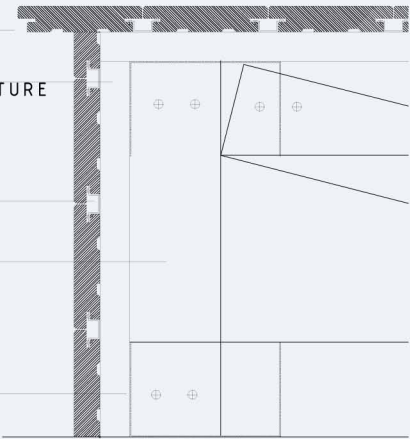

BC - 49

DATE: 08.04.2005

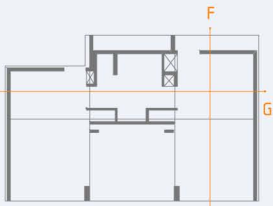

SEVERAL SCALES

SCALE_ 1:50

SCALE_ 1:5

COORDINATORS SUPERVISORS DE CATHLETES

MERCEDES PEÑA
ISABEL MONTANÉS
plan designer

CARLOS BERMEJO
design coordinator

MIGUEL GOMEZ
general coordinator

JOE WORCESTER
professional engineer

ALFONSO GARCIA-SANTOS
construction manager

JAVIER NEILA
architecture manager

ESTEFANIA CAAMAÑO
general coordinator



Universidad Politécnica de Madrid (UPM)



07/07

BC - 49

OUTDOOR AREAS