


UPM 2005

A - 13

DATE: 08.04.2005

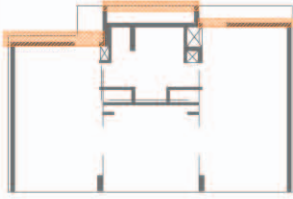

01/01

A - 13

SCALE_1:40

0 0.5 1m

0 1 2 3ft

1:40

NORTH SIDE

COORDINATORS

ALFONSO GARCIA-SANTOS
construction manager

JAVIER NEILA
architecture manager

ESTEFANIA CAAMAÑO
general coordinator


SUPERVISORS

DANIEL CARDOSO
plan designer

CARLOS BERMEJO
design coordinator

MIGUEL GOMEZ
general coordinator

DECATHLETES



magic BOX

Intelling under the sun

Universidad Politécnica de Madrid (UPM)