
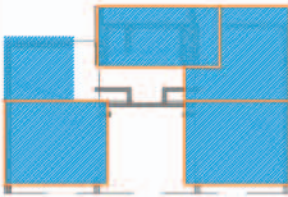
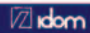

 2005 UPM			
BC - 35		01/02	
DATE: 08.04.2005			
		BC - 35	
SEVERAL_SCALE			
DECATHLETES			
LUIS CLIMENT plan designer			
CARLOS BERMEJO design coordinator			
MIGUEL GOMEZ general coordinator			
 ENGINEERING, ARCHITECTURE AND CONSULTING			
ANTONIO VILLANUEVA 100M industrial engineer			
ESTEFANIA CAAMAÑO general coordinator			
JAVIER NEILA architecture manager			
ALFONSO GARCIA-SANTOS construction manager			
COORDINATORS SUPERVISORS		ROOF DETAILS	
 unfolding under the sun Universidad Politécnica de Madrid (UPM)			