




S-20

DATE: 08.04.2005

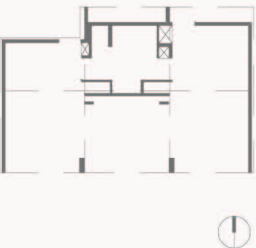

S-20

01/01

SCALE 1:10



1:10

COORDINATORS SUPERVISORS DECATHLETES

RAFAEL PALOMARES
MERCEDES PEÑA
plan designer

CARLOS BERMEJO
design coordinator

MIGUEL GOMEZ
general coordinator

MOVABLE WALLS

ALFONSO GARCIA-SANTOS
construction manager

JAVIER NEILA
architecture manager

ESTEFANIA CAAMAÑO
general coordinator



magic BOX

Universidad Politécnica de Madrid (UPM)