




BATHROOM
CLOSET_40x43x220cm

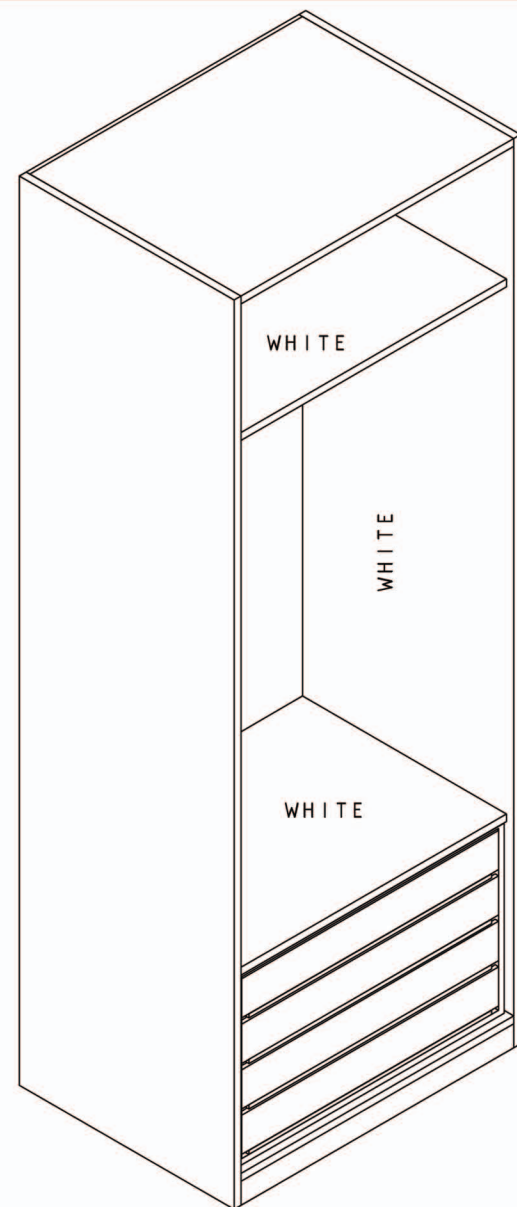

BEDROOM CLOSET_80x60x220cm

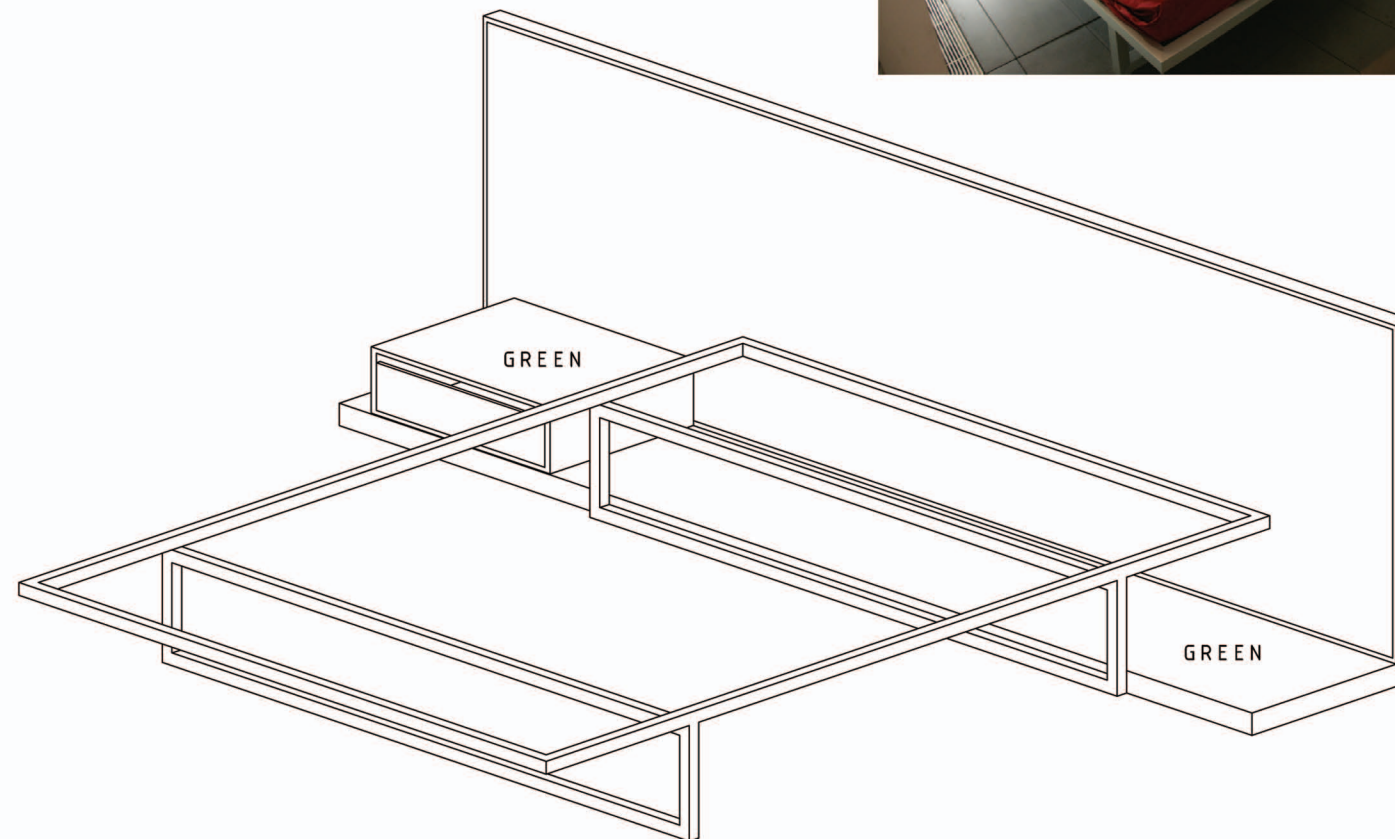

BED_200x145x27cm + HEADBOARD_VERT.255x75x5cm / HORIZ.255x45x5cm
BEDSIDE DRAWERS_40x50x14cm

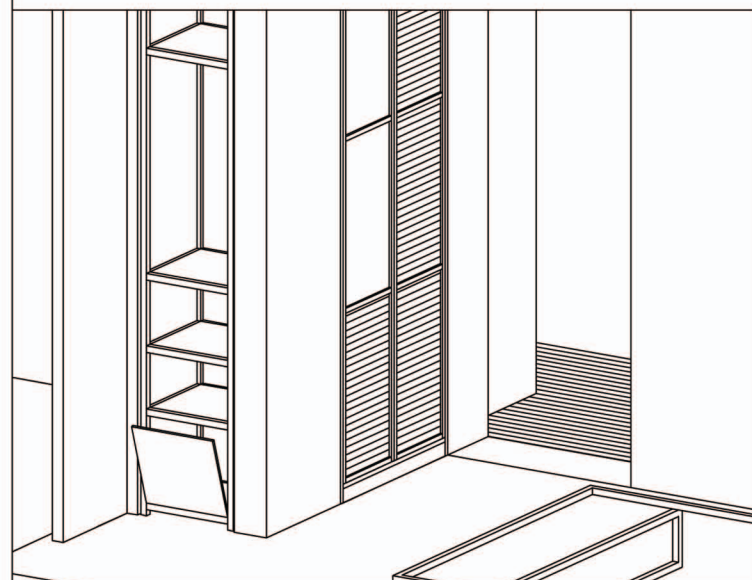

BEDROOM FURNITURE + BATHROOM CLOSET



BATHROOM CLOSET: ALUMINUM FRAMING WITH WHITE, GREEN AND WENGE COLOUR PANELS

BEDROOM CLOSET: WHITE BOARD STRUCTURE, WITH A SET OF 4 DRAWERS + HANGERS

BED: ALUMINUM STRUCTURE

HEADBOARD: ALUMINUM STRUCTURE WITH GREEN COLOUR PANEL FOR THE HORIZONTAL PIECE AND WHITE METHACRYLATE FOR THE VERTICAL PIECE (LIGHTS THE BED WITH THE FLUORESCENTS HIDDEN IN THE HEADBOARD)

BEDSIDE DRAWERS: WHITE FINISH AND ONE DRAWER

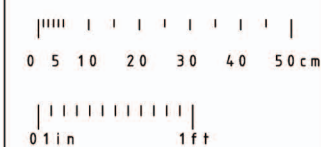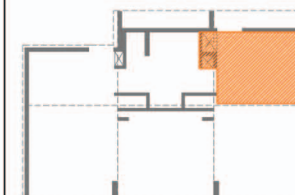

MONICA ALMAGRO
plan designer

CARLOS BERMEJO
design coordinator

MIGUEL GOMEZ
general coordinator

ALFONSO GARCIA-SANTOS
construction manager

JAVIER NEILA
architecture manager

ESTEFANIA CAAMAÑO
general coordinator