
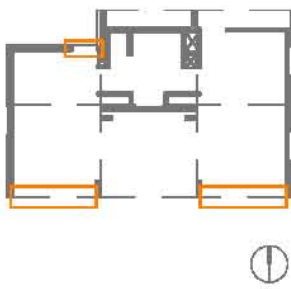

 SOLAR DECATHLON 2005 UPM Madrid		
BC - 47 DATE: 08.04.2005		
		BC - 47 03/07
SEVERAL SCALES		SEVERAL SCALES
1 : 20 1 : 5		
DECATHLETES	José Luis Pérez-Griffo plan designer	GLAZING AND FRAMING
	CARLOS BERMEJO design coordinator	
	MIGUEL GÓMEZ general coordinator	
COORDINATORS	ALFONSO GARCÍA-SANTOS construction manager	
	JAVIER NEILA architecture manager	
	ESTEFANÍA CAAMAÑO general coordinator	
 unfolding under the sun Universidad Politécnica de Madrid (UPM)		