




MAIN PLAN

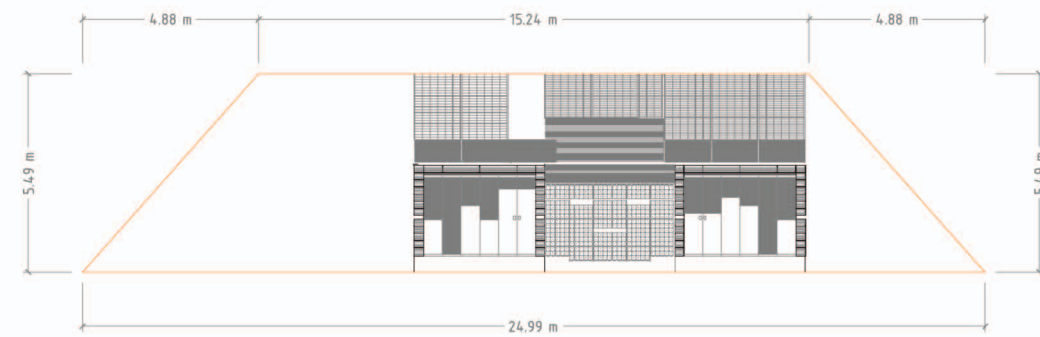


SOUTH ELEVATION

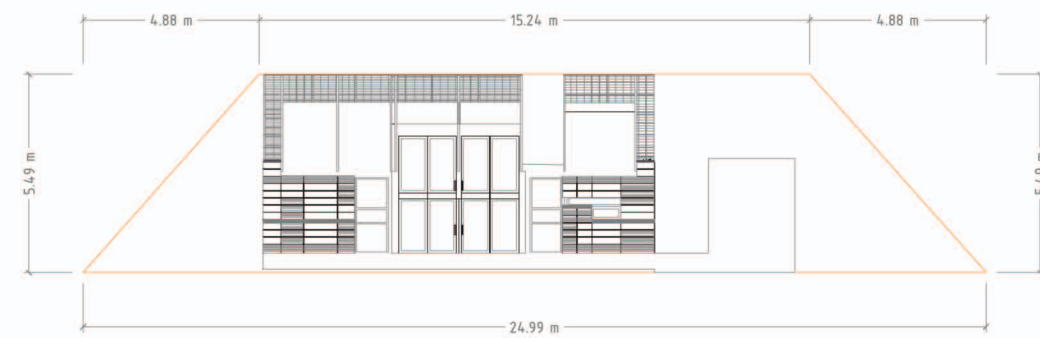

NORTH ELEVATION

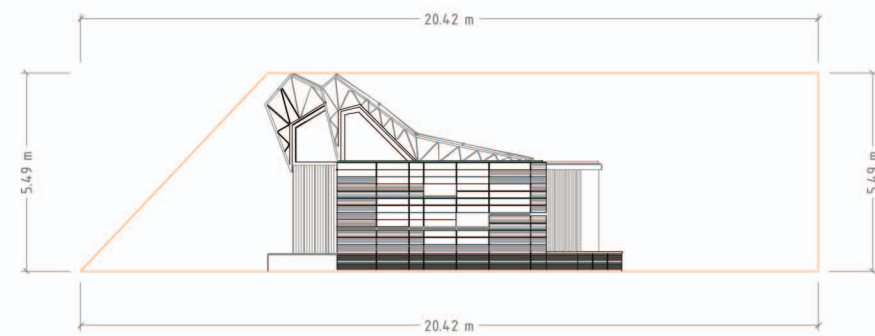

WEST ELEVATION

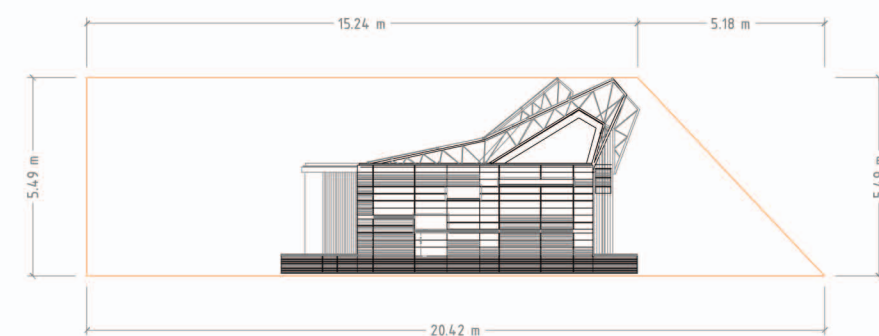


EAST ELEVATION



SE - 01


DATE: 08.04.2005

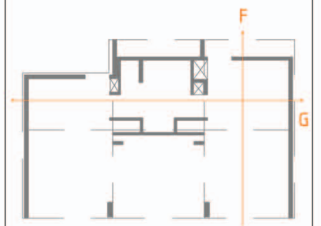

01/01

SE - 01

SCALE_1:200

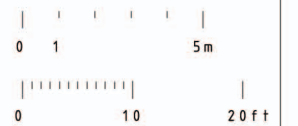

1:200

COORDINATORS SUPERVISORS DE CATHETES

HELDER J. MARTINS
plan designer

CARLOS BERMEJO
design coordinator

MIGUEL GOMEZ
general coordinator

ALFONSO GARCIA-SANTOS
construction manager

JAVIER NEILA
architecture manager

ESTEFANIA CAAMAÑO
general coordinator

SOLAR ENVELOPE



Universidad Politécnica de Madrid (UPM)