



BC - 28

DATE: 08.04.2005

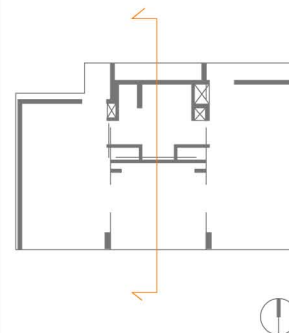

SCALE\_1:40

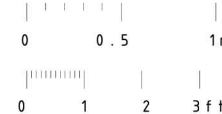

COORDINATORS SUPERVISORS DECATHLETES

CARLOTREZZO  
plan designer

CARLOS BERMEJO  
design coordinator

MIGUEL GOMEZ  
general coordinator

JOE WORCESTER  
professional engineer

ALFONSO GARCIA-SANTOS  
construction manager

JAVIER NEILA  
architecture manager

ESTEFANIA CAAMAÑO  
general coordinator



unfolding under the sun  
Universidad Politécnica de Madrid (UPM)

01/01

BC - 28

1:40

SECTION C: BATHROOM (FOLDED)