

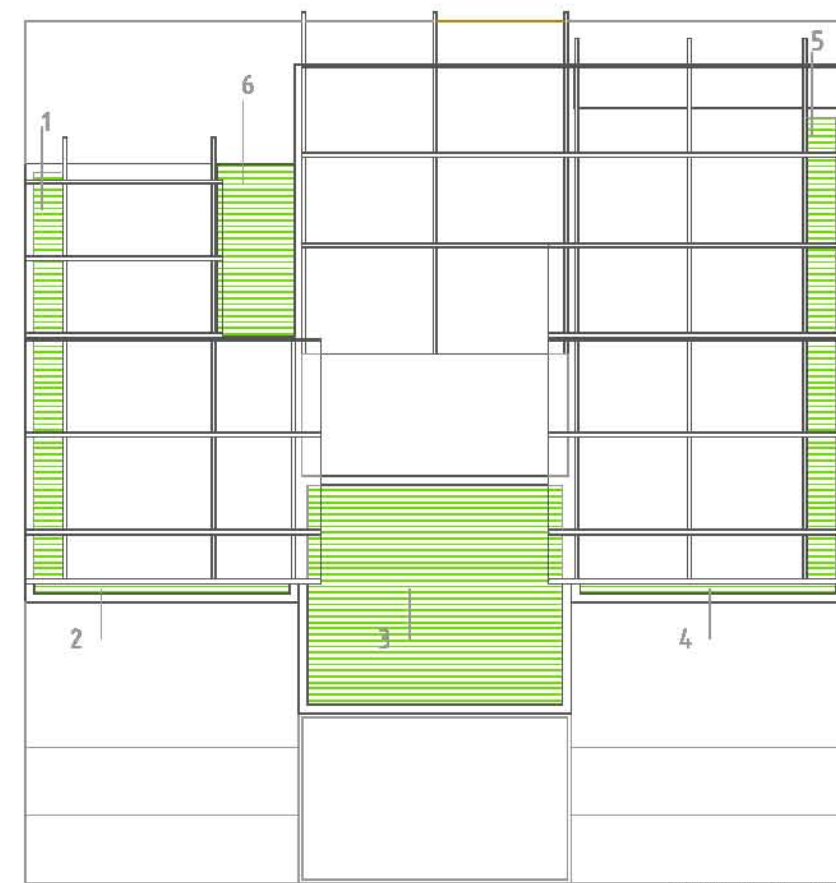


SECTION B
SCALE_1:20

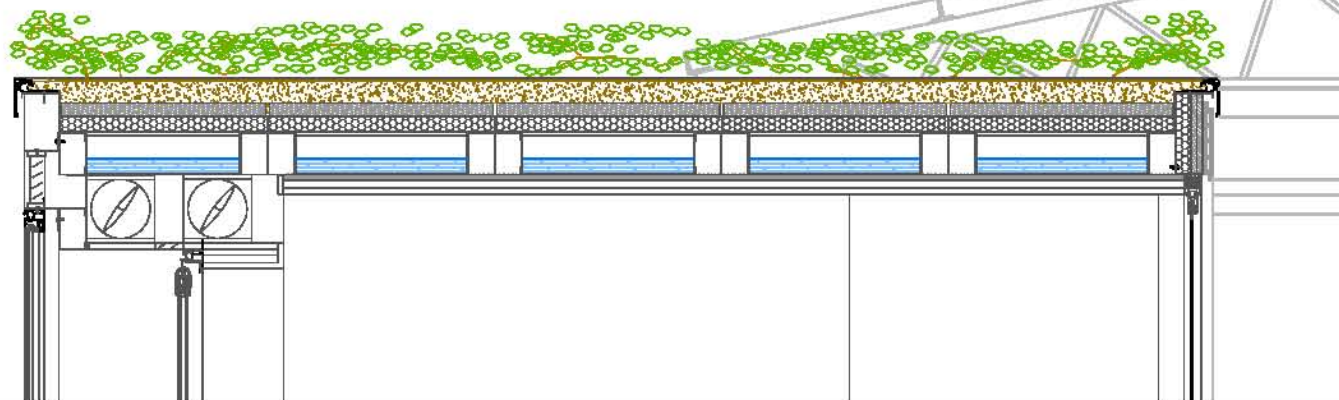


SECTION A

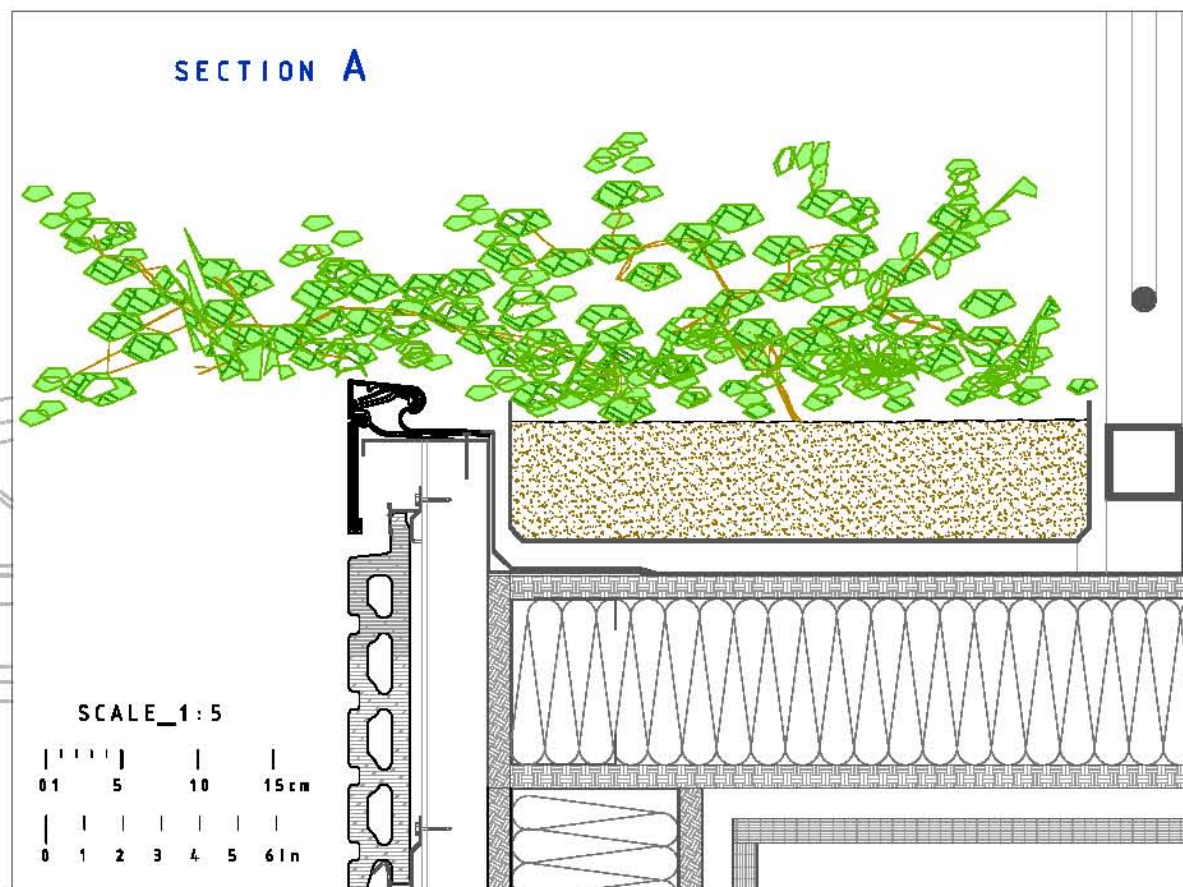


BC-36

DATE: 08.04.2005

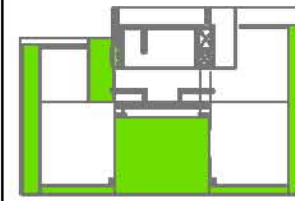

SCALE_1:50

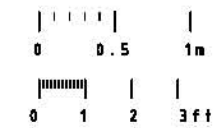

LUIS CLIMENT
plan designer

CARLOS BERMEJO
design coordinator

MIGUEL GOMEZ
general coordinator

ESTEFANIA CAAMAÑO
general coordinator

JAVIER NEILA
architecture manager

ALFONSO GARCIA-SANTOS
construction manager



unfolding under the sun
Universidad Politécnica de Madrid (UPM)



01/01

BC-36

1:50

GREEN ROOF