

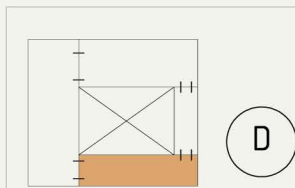
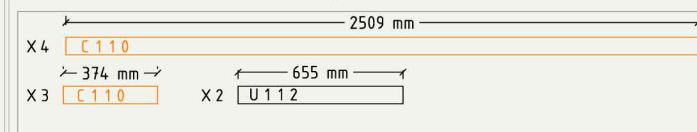
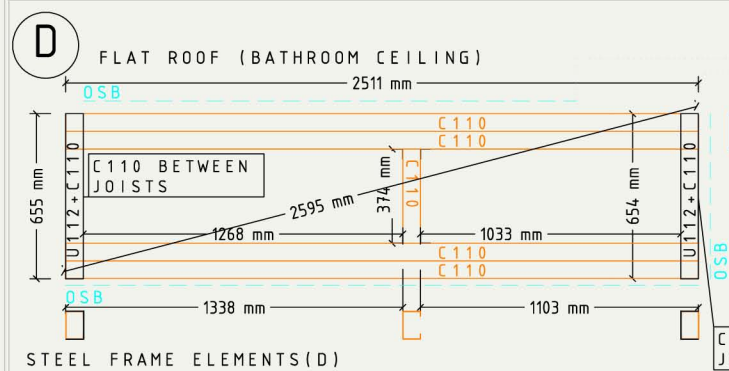
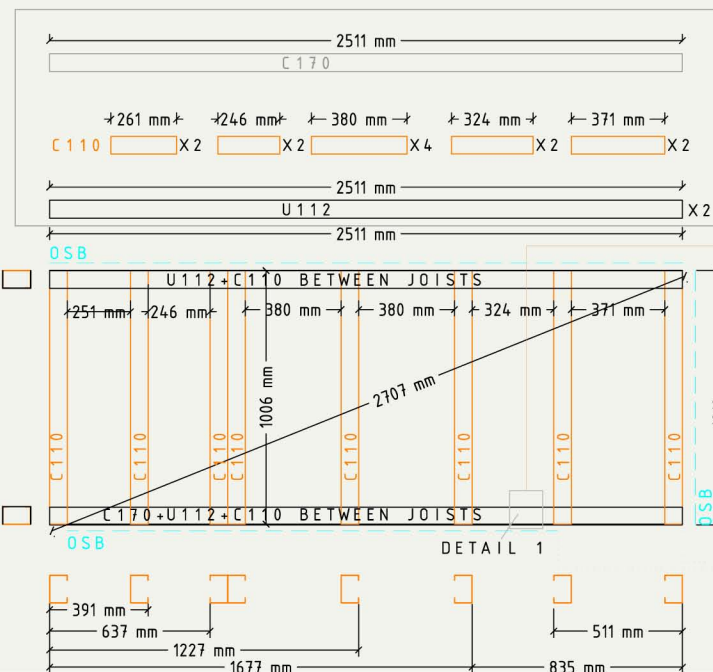
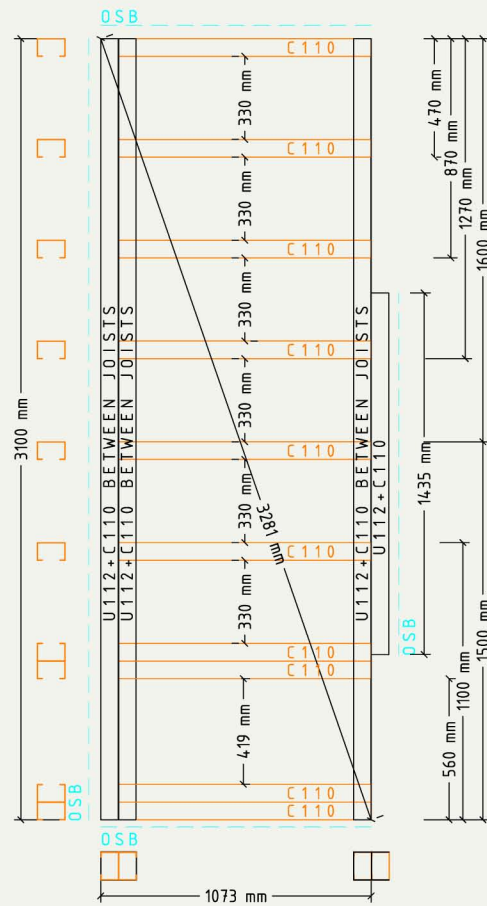
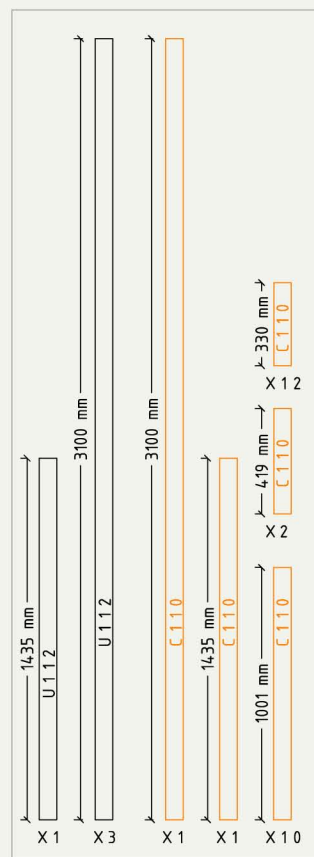
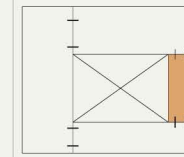
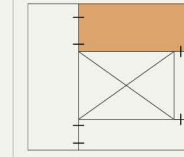
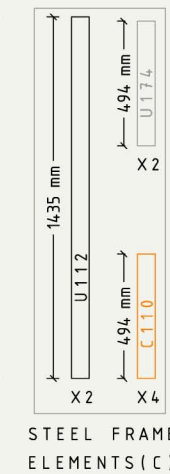


## FLAT ROOF LAYOUT (BATHROOM CEILING)

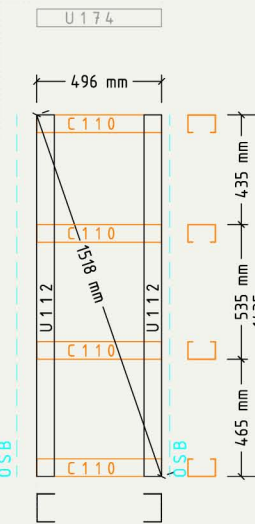

NOTE: THE 4 FLAT ROOF AREAS ARE FASTENED WITH SCREWS AND WORK AS A SINGLE STRUCTURAL ELEMENT.

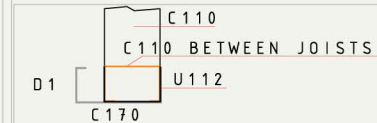


CEILING ROOF

FLAT ROOF



S - 22

DATE: 08.04.2005

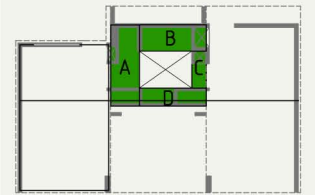

08/11

S-22

SCALE\_1:30



1:30

DECATHLETES

LETICIA RO-BER  
plan designer

CARLOS BERMEJO  
design coordinator

MIGUEL GOMEZ  
general coordinator

COORDINATORS U

JOE WORCESTER  
professional engineer

ALFONSO GARCÍA-SANTOS  
construction manager

JAVIER NEILA  
architecture manager

ESTEFANÍA CAAMAÑO  
general coordinator



unfolding under the sun

Universidad Politécnica de Madrid (UPM)