


SECTION (NORTH-SOUTH)

E: 1/15

CROSS SECTION (EAST-WEST)


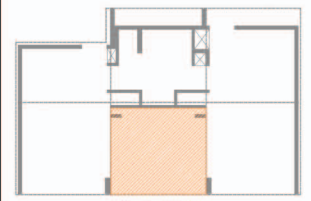


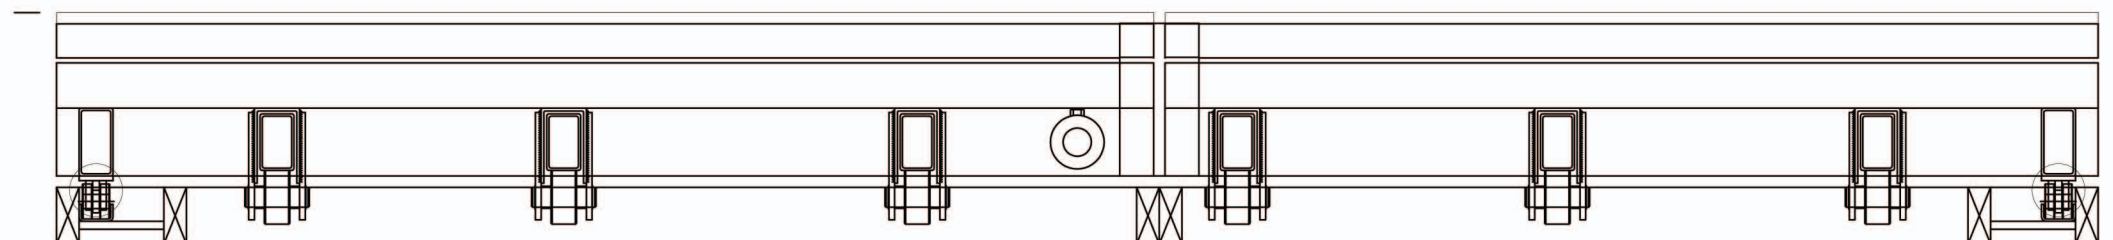

MOBILE BOX. UNFOLDED LAYOUT



Photograph. Mobile Box during construction.



	
S - 19 DATE: 08.04.2005	
	S - 19 01/06
SCALE_1:30 	
COORDINATORS SUPERVISORS DECATHLETES JOAQUIN HIDALGO plan designer CARLOS BERMEJO design coordinator MIGUEL GOMEZ general coordinator	
JOE WORCESTER professional engineer	
ALFONSO GARCIA-SANTOS construction manager JAVIER NEILA architecture manager ESTEFANIA CAAMAÑO general coordinator	
MOVABLE MODULE	
 unfolding under the sun Universidad Politécnica de Madrid (UPM)	