


BC - 32

DATE: 08.04.2005

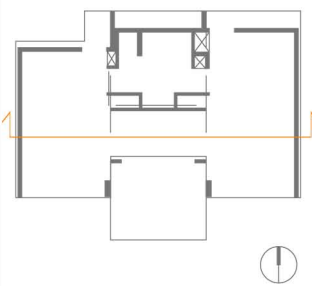

BC - 32

SCALE_1:40

0 0.5 1m

0 1 2 3ft

COORDINATORS SUPERVISORS DECATHLETES

CARLOTREZZO
plan designer

CARLOS BERMEJO
design coordinator

MIGUEL GOMEZ
general coordinator

JOE WORCESTER
professional engineer

ALFONSO GARCIA-SANTOS
construction manager


JAVIER NEILA
architecture manager

ESTEFANIA CAAMAÑO
general coordinator

SECTION G: LOUNGE (UNFOLDED)

1:40

01/01



unfolding under the sun

Universidad Politécnica de Madrid (UPM)