


A - 14

DATE: 08.04.2005

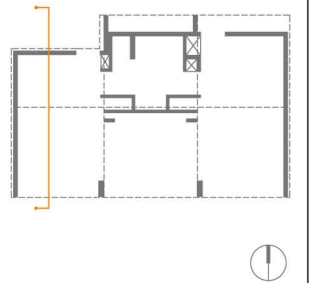

01/01

A - 14

SCALE_1:40



1:40

MONICA ALMAGRO
plan designer

CARLOS BERMEJO
design coordinator

MIGUEL GOMEZ
general coordinator

COORDINATORS SUPERVISORS

ALFONSO GARCIA-SANTOS
construction manager

JAVIER NEILA
architecture manager

ESTEFANIA CAAMAÑO
general coordinator

DINING ROOM + KITCHEN SECTION



Universidad Politécnica de Madrid (UPM)