


**BC - 33**

DATE: 08.04.2005

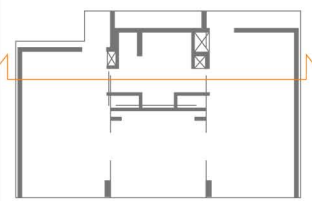

01/01

**BC - 33**

SCALE\_1:40

0 0.5 1m

0 1 2 3ft

COORDINATORS SUPERVISORS DE CATHLETES

CARLOTREZZO  
plan designer

CARLOS BERMEJO  
design coordinator

MIGUEL GOMEZ  
general coordinator


JOE WORCESTER  
professional engineer

ALFONSO GARCIA-SANTOS  
construction manager

JAVIER NEILA  
architecture manager

ESTEFANIA CAAMAÑO  
general coordinator

**SECTION H: KITCHEN + BEDROOM**



unfolding under the sun

Universidad Politécnica de Madrid (UPM)