

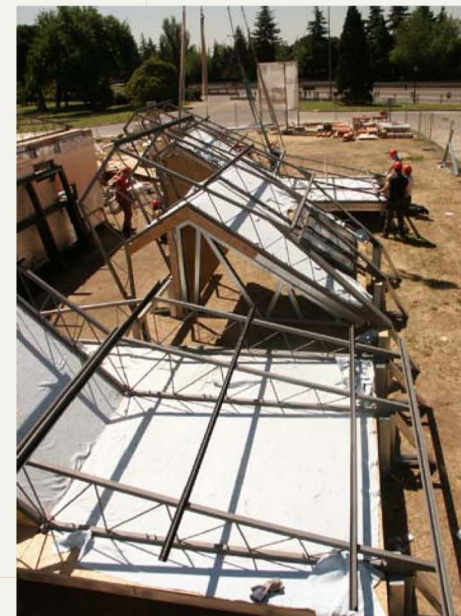
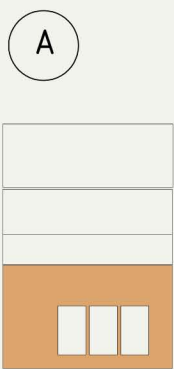
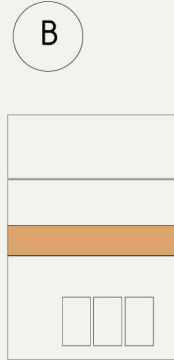


## AREA 2

### SLOPED ROOF LAYOUT (BATHROOM)

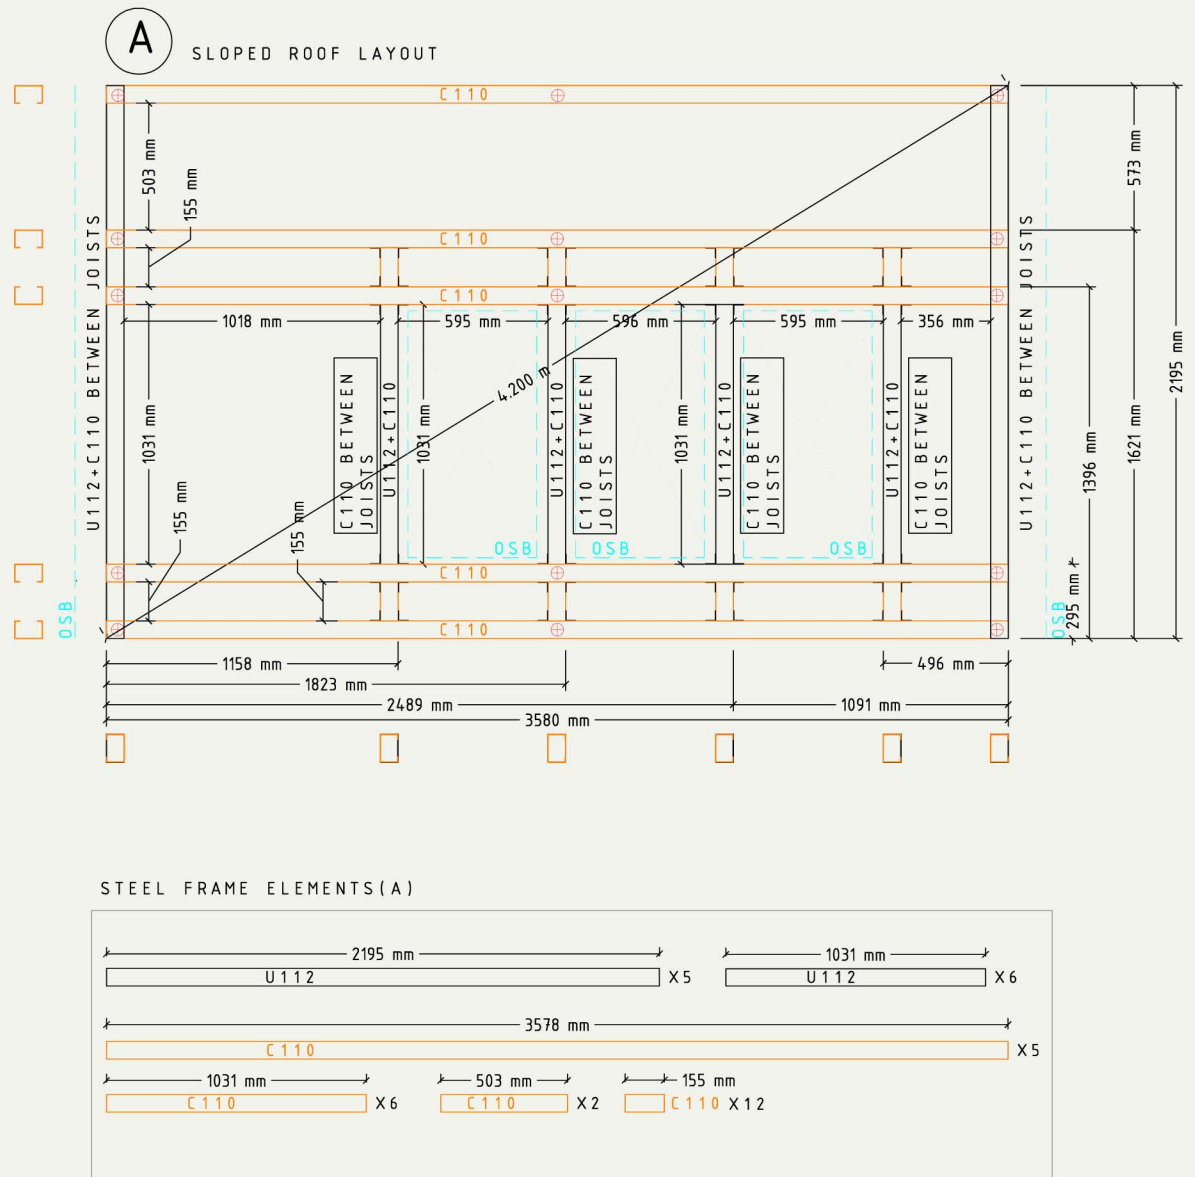


GENERAL VIEW: ROOF  
LAYOUT

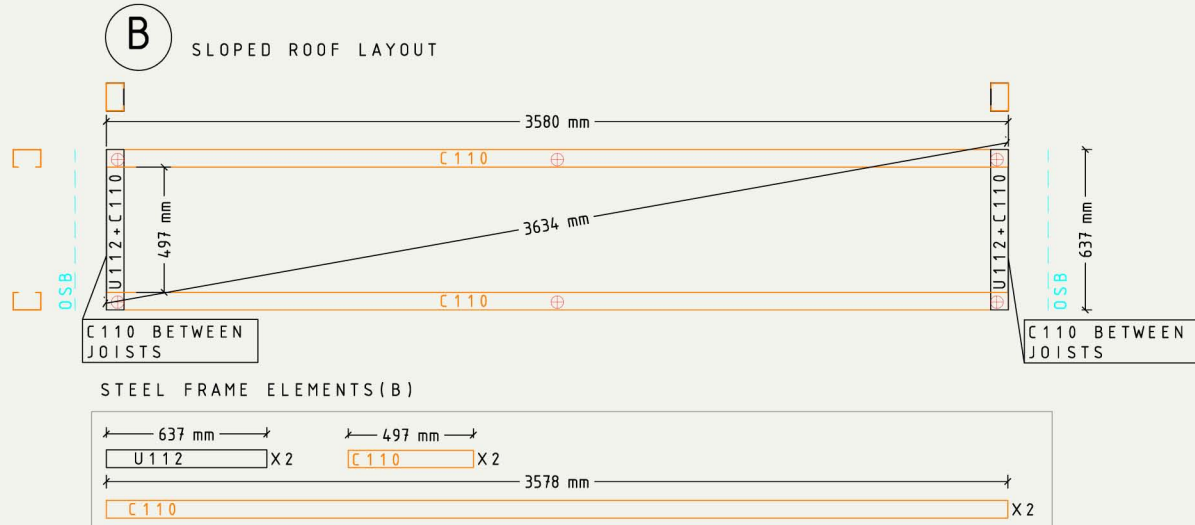

S - 22


DATE : 08.04.2005

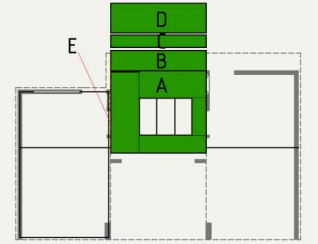

09/11

77-22

SCALE\_1:30

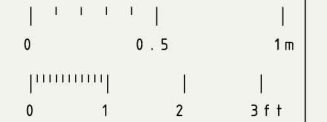

1:30

DECATHLETES

LETICIA RO-BER  
plan designer

CARLOS BERMEJO  
design coordinator

**MIGUEL GOMEZ**  
general coordinator

US	U
----	---

JOE WORCESTER  
professional engineer

[illegible]

ALFONSO GARCÍA-SANTOS  
construction manager

10

JAVIER NEILA  
architecture manager

0.3

ESTEFANÍA CAAMAÑO  
general coordinator



Universidad Politécnica de Madrid (UPM)