



P - 55

DATE: 08.04.2005

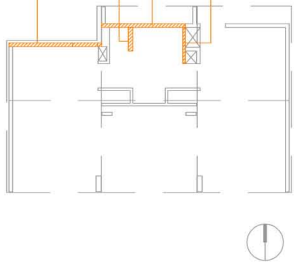

SCALE\_1:25

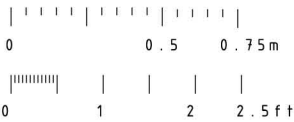

SOFIA MELERO GONZALO USED  
plan designer

CARLOS BERMEJO  
design coordinator

MIGUEL GOMEZ  
general coordinator



ANTONIO VILLANUEVA  
IDOM/professional supervisor

ALFONSO GARCIA-SANTOS  
construction manager

JAVIER NEILA  
architecture manager

ESTEFANIA CAAMAÑO  
general coordinator



unfolding under the sun  
Universidad Politécnica de Madrid (UPM)

05/07

P - 55

1:25

PLUMBING DRAWINGS - ELEVATIONS