


20 mt.

DAY 5

INTERIOR FINISHES
DECKS

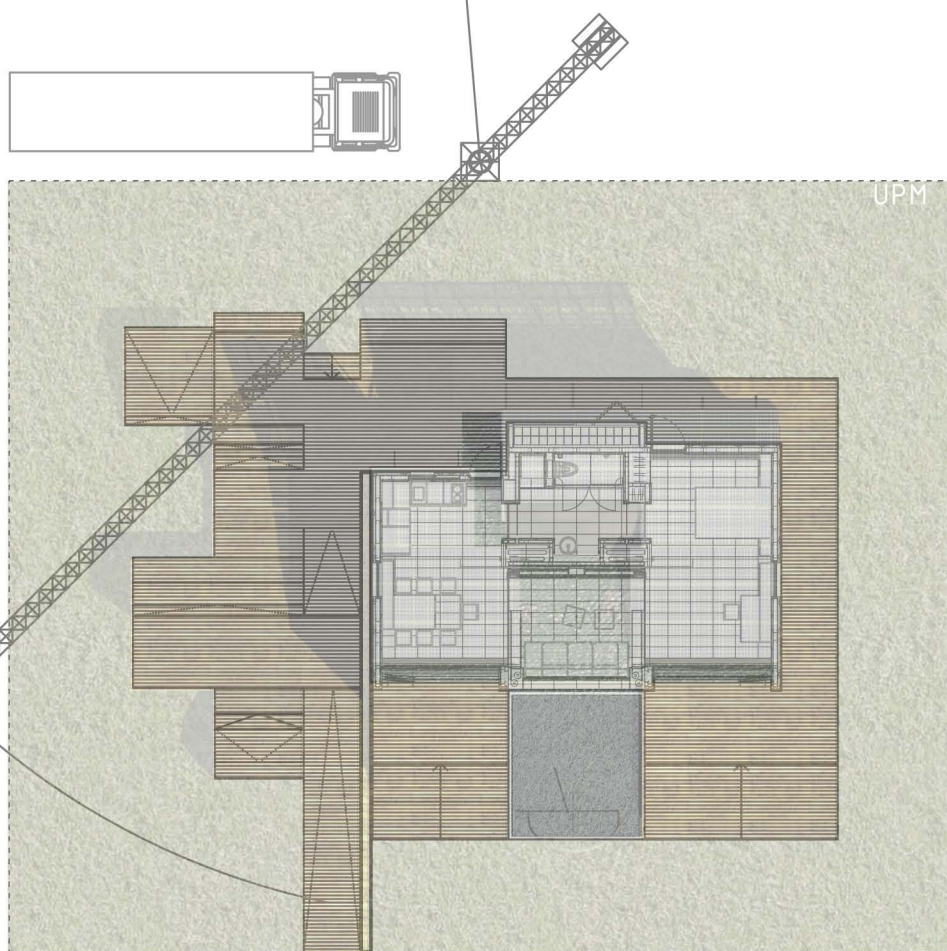

S0-62


DATE: 08.04.2005



03 / 03

S0 - 62

SCALE_1:200

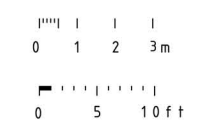

1:200

COORDINATORS SUPERVISORS DECATHLETES

IVÁN ALCANTARILLA
plan designer

CARLOS BERMEJO
design coordinator

MIGUEL GOMEZ
general coordinator

COORDINATORS

ALFONSO GARCIA-SANTOS
construction manager

JAVIER NEILA
architecture manager

ESTEFANIA CAAMAÑO
general coordinator

SITE OPERATIONS

