


BC - 38

DATE: 2005.02.04



SCALE_1:40

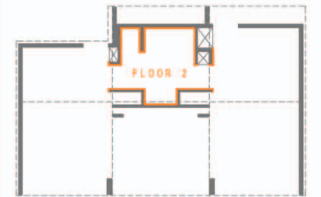

DESIGNERS

MONICA ALMAGRO
plan designer

CARLOS BERMEJO
design coordinator

MIGUEL GOMEZ
general coordinator

COORDINATORS

ALFONSO GARCIA-SANTOS
construction manager

JAVIER NEILA
architecture manager

ESTEFANIA CAAMAÑO
general coordinator



Universidad Politécnica de Madrid (UPM)



05/07

BC - 38

1:40

PANELS: BATHROOM