

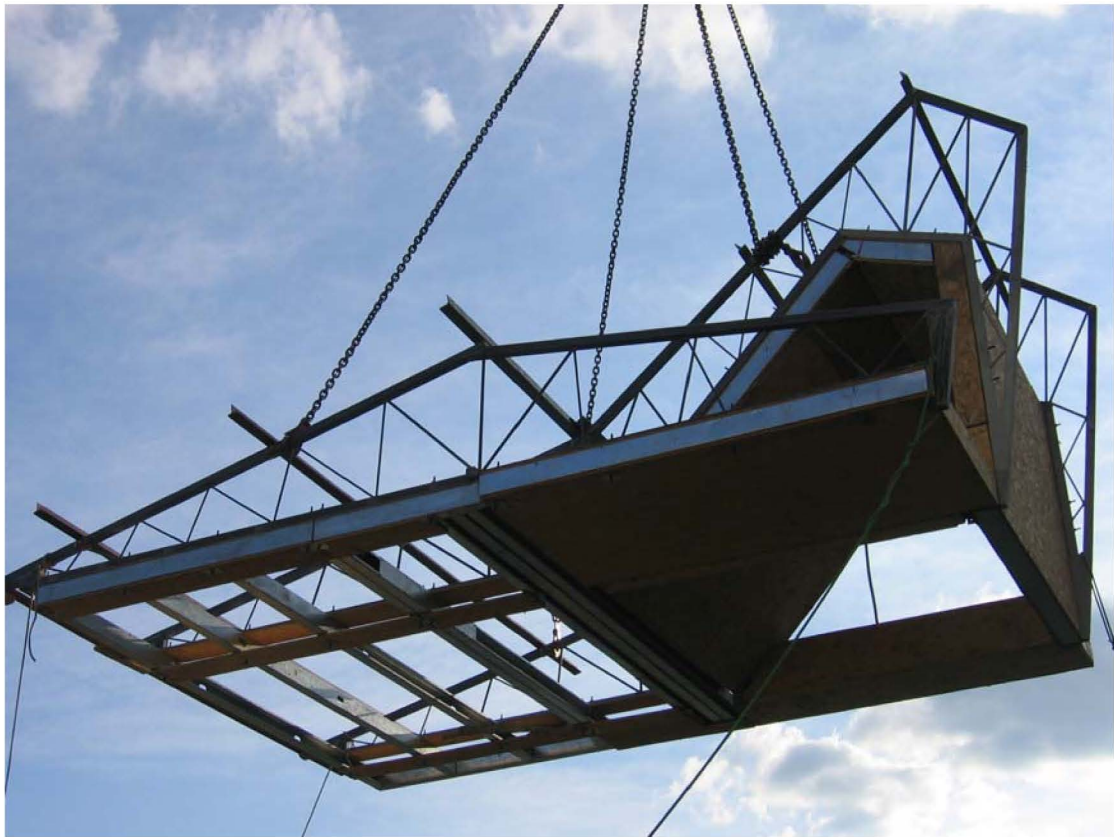
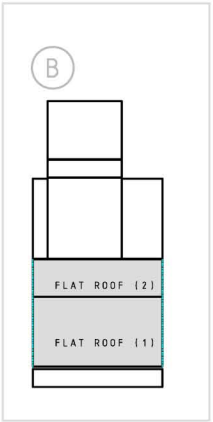



AREA 1 OSB FLAT ROOF PANELS (KITCHEN & DINNING ROOM LAYOUT)

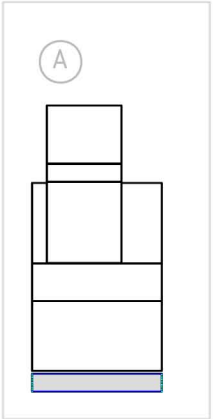


OSB ROOF PANELS (A)

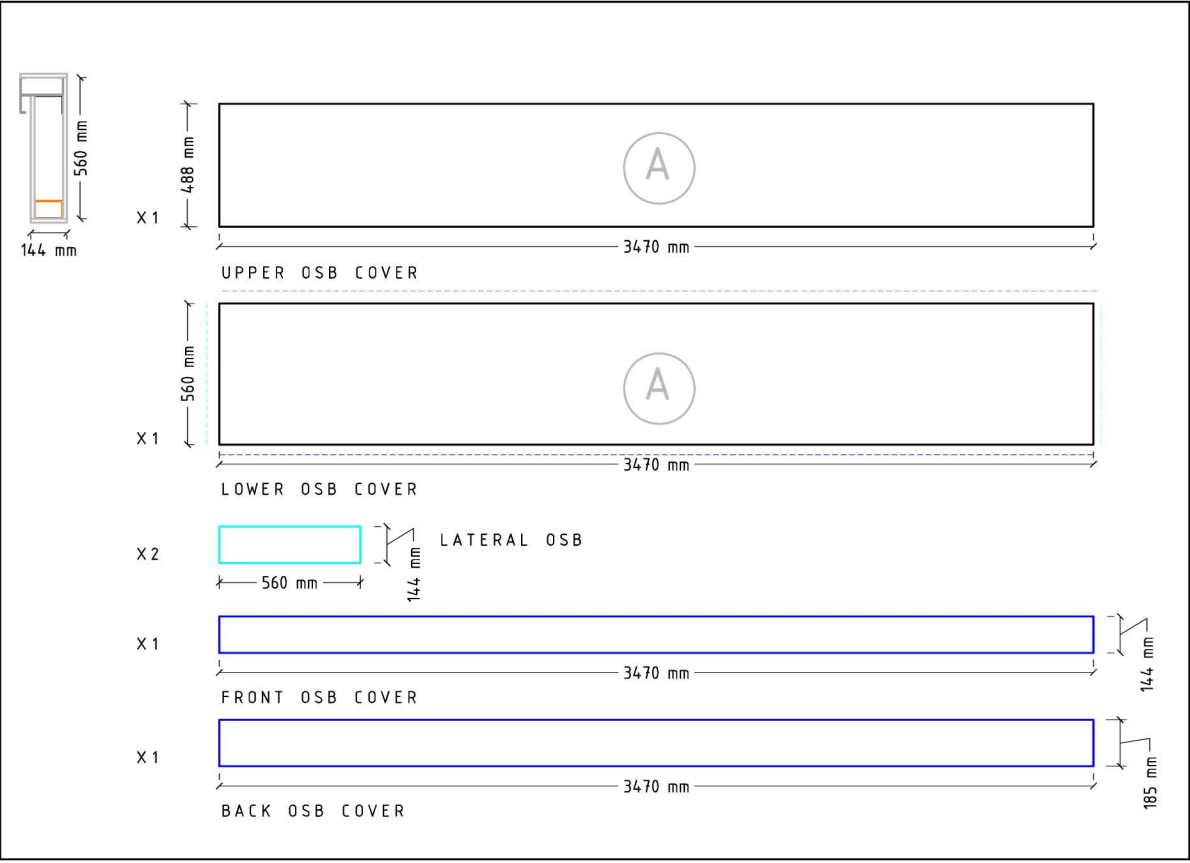


OSB ROOF PANELS (B)

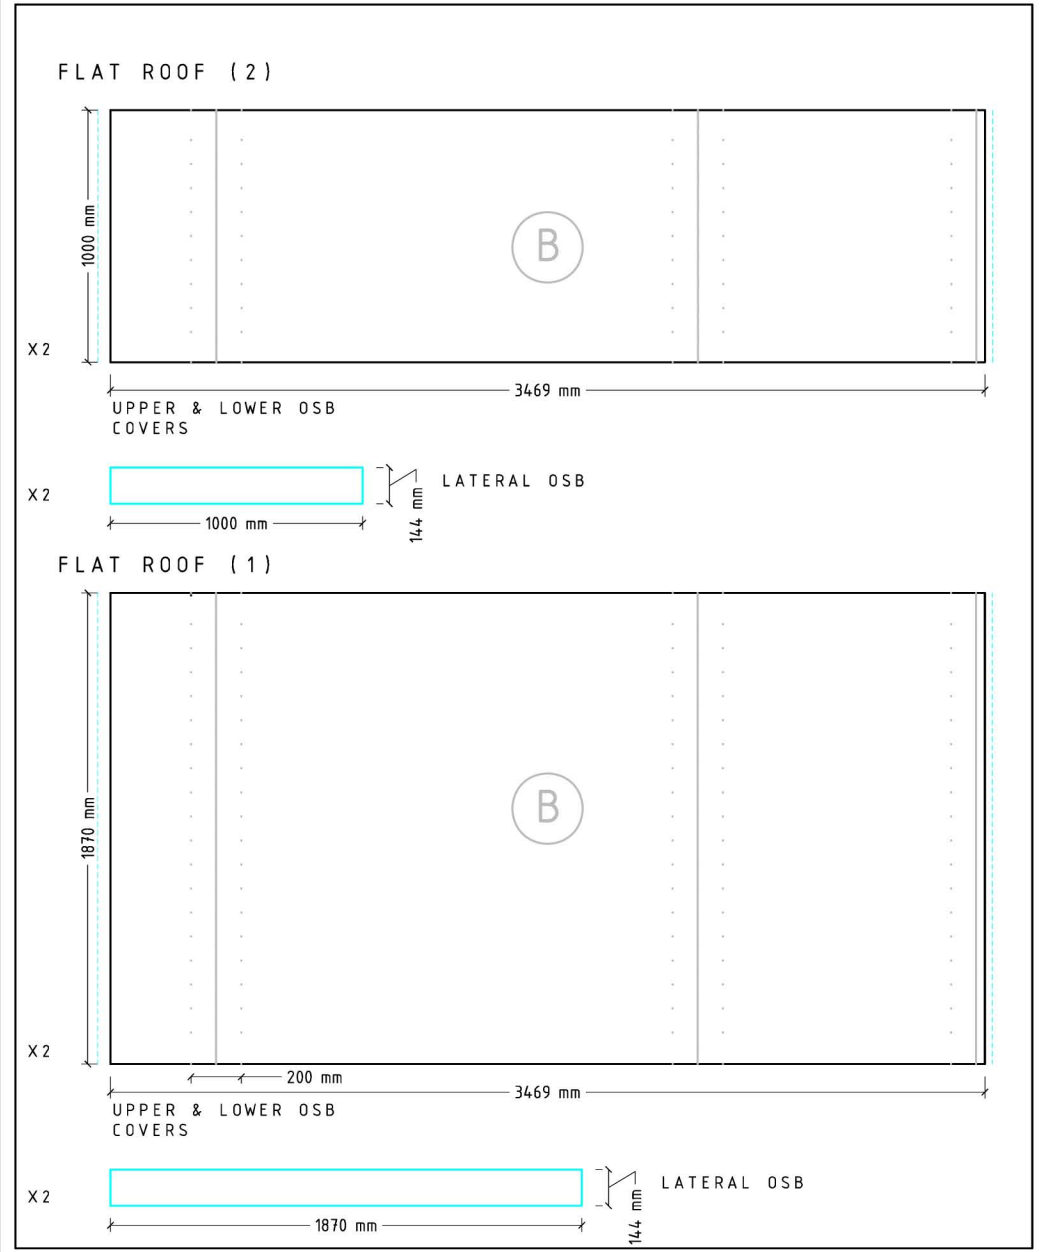



S - 22

DATE: 08.04.2005

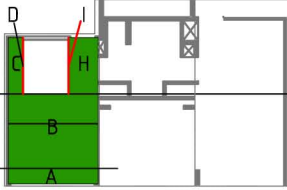

SCALE\_1:30

0 0.5 1m

0 1 2 3ft

LETICIA RO-BER  
plan designer

CARLOS BERMEJO  
design coordinator


MIGUEL GOMEZ  
general coordinator

JOE WORCESTER  
professional engineer

ALFONSO GARCIA-SANTOS  
construction manager

JAVIER NEILA  
architecture manager

ESTEFANIA CAAMAÑO  
general coordinator



unfolding under the sun

Universidad Politécnica de Madrid (UPM)

S - 22

01/10

1:30

OSB PANELS: ROOF LAYOUT