


DAY 1


ASSEMBLED ELEMENT  
BATHROOM MODULE  
PACKING LIST REFERENCE  
1.4.1.1  
ESTIMATED TIME OF ASSEMBLY  
2 HOURS




WEST ELEVATION

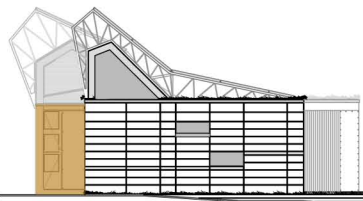

NORTH ELEVATION

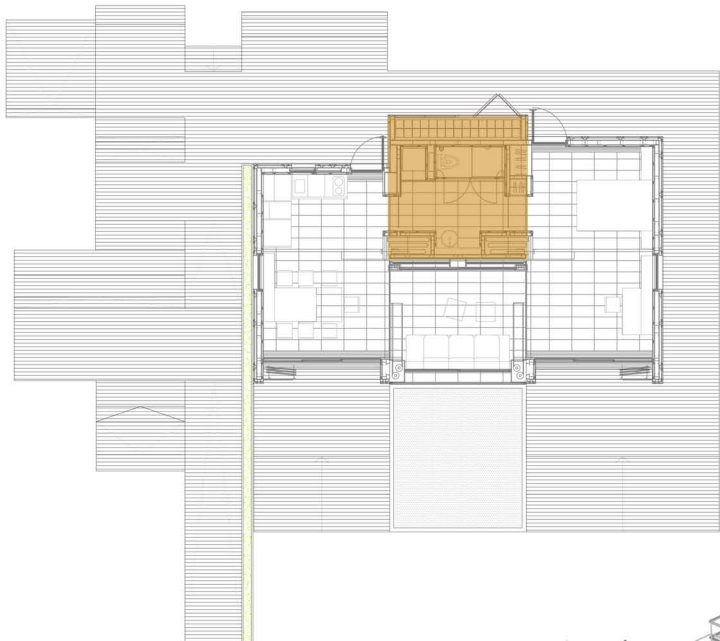

CROSS SECTION

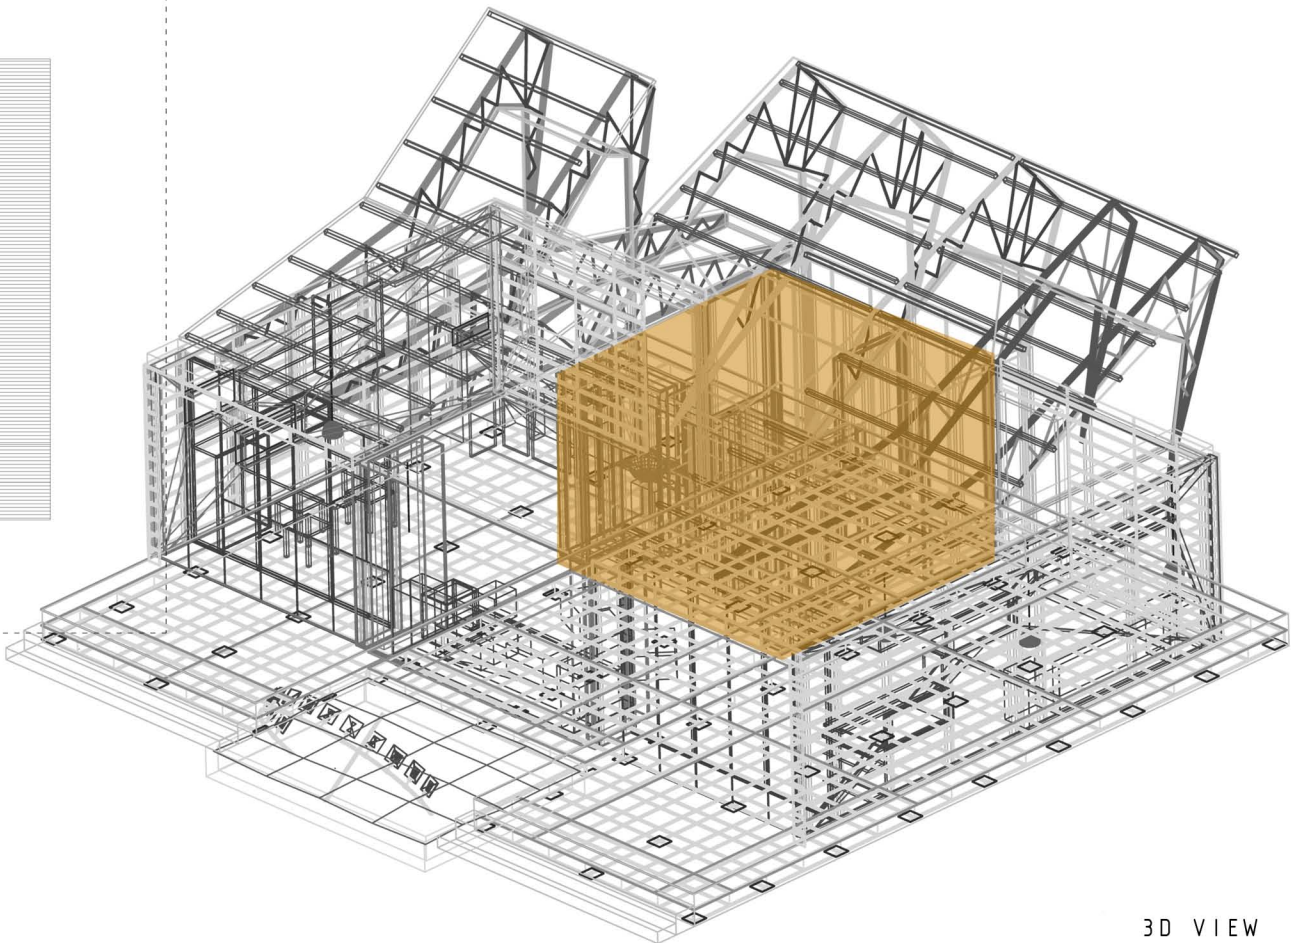


3D VIEW




AD-59

DATE: 08.04.2005

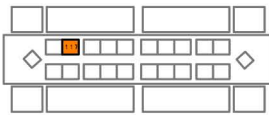

SCALE 1:200

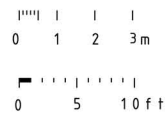

DECATHLETES  
IVÁN ALCANTARILLA  
plan designer  
CARLOS BERMEJO  
design coordinator  
MIGUEL GOMEZ  
general coordinator

COORDINATORS  
ALFONSO GARCIA-SANTOS  
construction manager  
JAVIER NEILA  
architecture manager  
ESTEFANIA CAAMAÑO  
general coordinator



unfolding under the sun  
Universidad Politécnica de Madrid (UPM)



01/10

AD-59

1:200

ASSEMBLY

