

① OUTDOOR TOUR

- ① ENTRY TO MAGIC BOX
- ② EXIT FROM MAGIC BOX
- ③ EXHIBITION AREAS
- ④ CHILDREN'S AREA
- ⑤ CARPORT
- ⑥ WHITE FELDSPAR STONES

INDOOR TOUR

- (A) MOVABLE WALLS (MOVING POSITION)*
- (B) BATHROOM EXPLANATION*
- (C) BATTERIES ROOM
- (D) EAST SIDE
- (E) GREENHOUSE*
- (F) MOVABLE WALLS (CLOSED POSITION)
- (G) LOUNGE MOVEMENT: PATIO SHOW **
- (H) DECK: HOUSE VIEWS & EXIT
- MAIN TOUR
- - - RAINY DAY TOUR

*THE DIFFERENT SHOWS WILL TAKE PLACE AT EACH TOUR PERFORMED BY A DECATHLETE.
 **THE PATIO SHOW WILL TAKE PLACE TWICE A DAY (MORNING/EVENING).




SM-64

DATE: 08.04.2005



SCALE_1:50

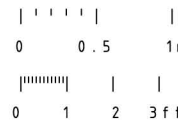

COORDINATORS SUPERVISORS DECATHLETES

RAFAEL PALOMARES
plan designer

CARLOS BERMEJO
design coordinator

MIGUEL GOMEZ
general coordinator

ALFONSO GARCIA-SANTOS
construction manager

JAVIER NEILA
architecture manager

ESTEFANIA CAAMAÑO
general coordinator



unfolding under the sun

Universidad Politécnica de Madrid (UPM)

01/02

SM-64

1:50

TOURS ON THE LOT: FOLDED LAYOUT