

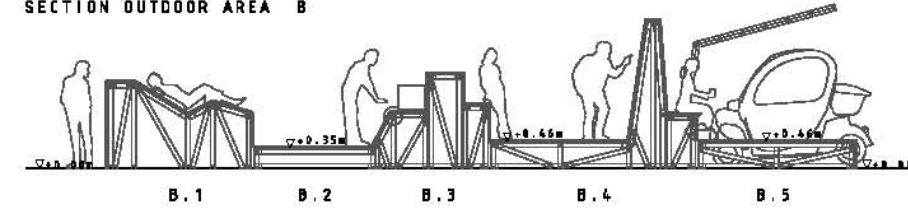


TOP OUTDOOR AREA B.4

SECTION OUTDOOR AREA B

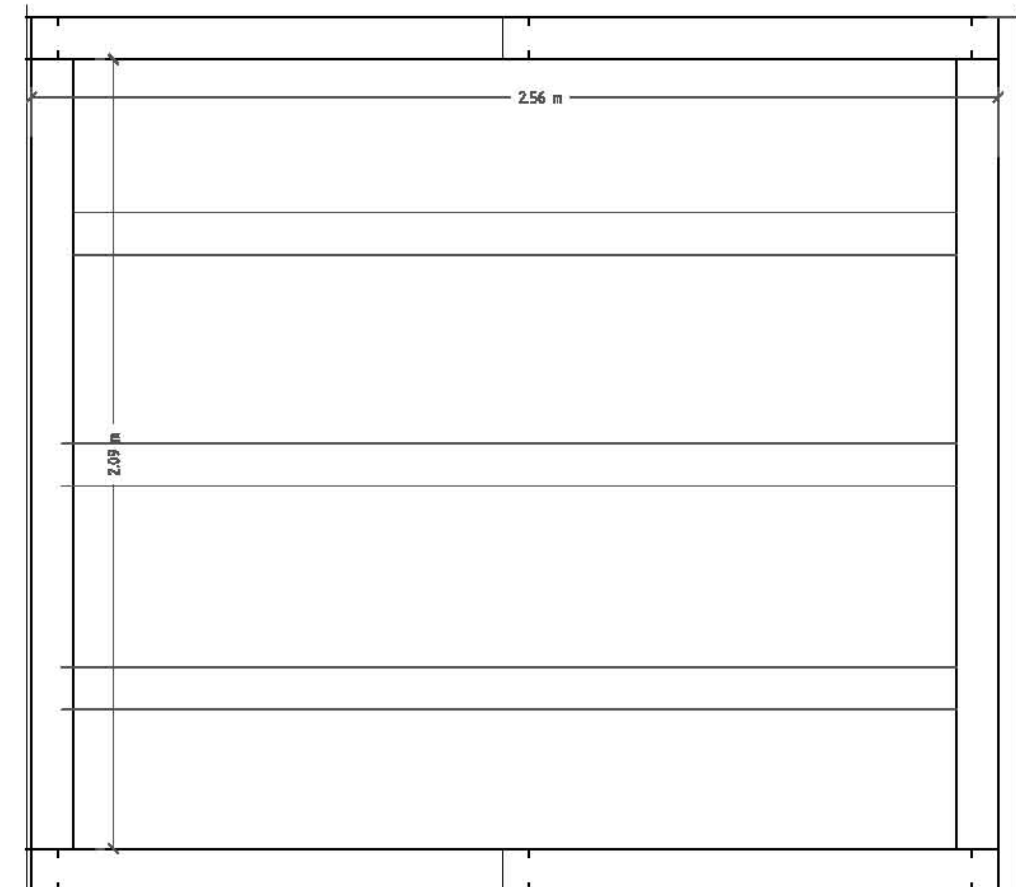

SECTION OUTDOOR AREA B.5

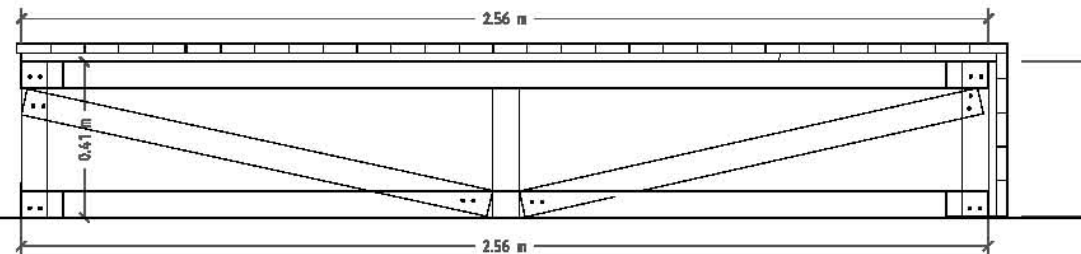


TOP OUTDOOR AREA B.5




BC-50

DATE: 08.04.2005

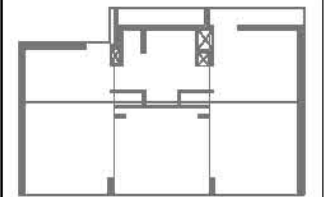

SCALE_1:20

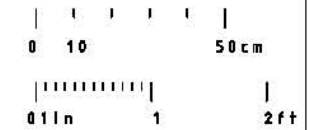

COORDINATORS SUPERVISORS DEATHLETES

MERCEDES PEÑA,
ISABEL MONTANES
plan designer

CARLOS BERMEJO
design coordinator

MIGUEL GOMEZ
general coordinator

JOE WORCESTER
professional engineer

ALFONSO GARCIA-SANTOS
construction manager

JAVIER NEILA
architecture manager

ESTEFANIA CAAMAÑO
general coordinator

OUTDOORS AREAS



unfolding under the sun
Universidad Politécnica de Madrid (UPM)