
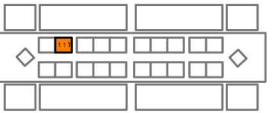
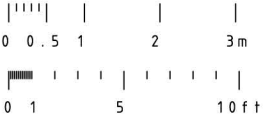


A-05
DATE : 08.04.2005



SCALE_1:100



COORDINATORS

ALFONSO GARCIA-SANTOS
construction manager

JAVIER NEILA
architecture manager

ESTEFANIA CAAMAÑO
general coordinator


SUPERVISORS

DECATHLETES

IVÁN ALCANTARILLA
plan designer

CARLOS BERMEJO
design coordinator

MIGUEL GOMEZ
general coordinator



unfolding under the sun
Universidad Politécnica de Madrid (UPM)

01/01

A - 05

1 : 100

SITE PLAN