



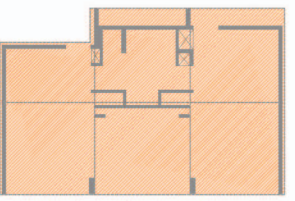
GROUND FLOOR MAIN PLAN



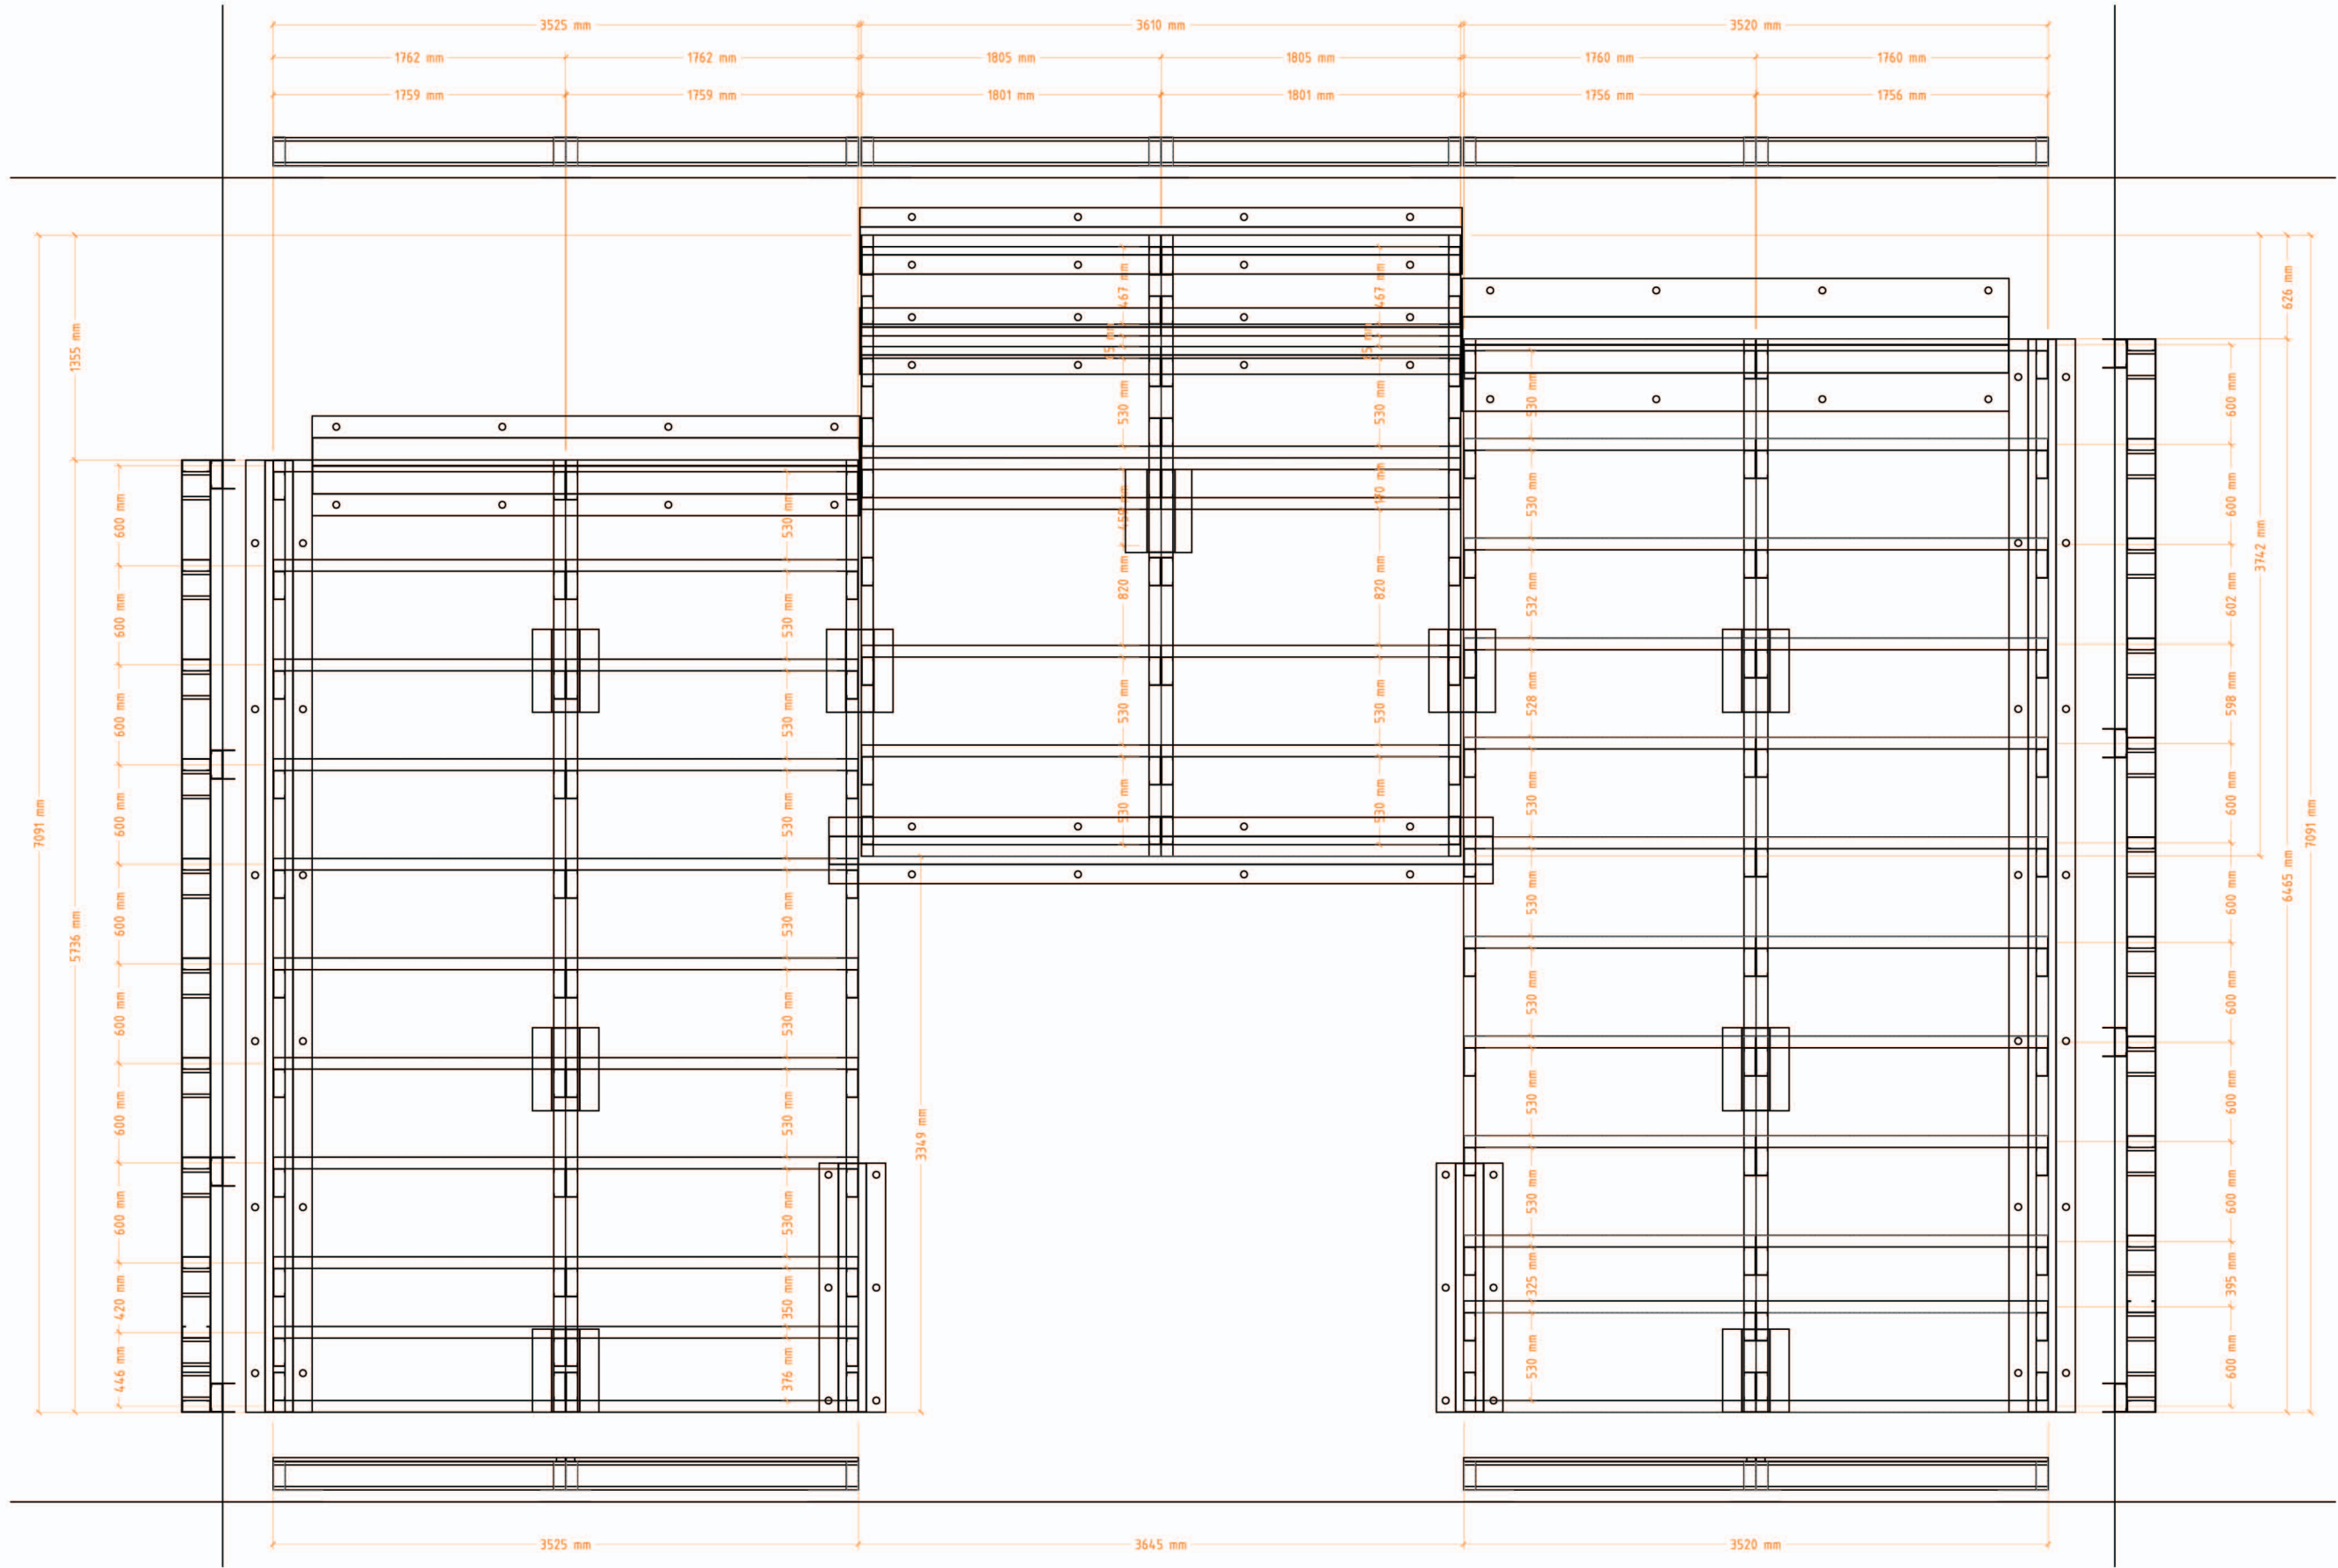

S - 18


DATE: 08.04.2005



02/05

S - 18

SCALE\_1:30

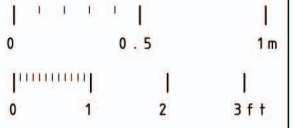

1:30

COORDINATORS

JOAQUIN HIDALGO  
plan designer

CARLOS BERMEJO  
design coordinator

MIGUEL GOMEZ  
general coordinator

SUPERVISORS

JOE WORCESTER  
professional engineer


CONSTRUCTORS

ALFONSO GARCIA-SANTOS  
construction manager

JAVIER NEILA  
architecture manager

ESTEFANIA CAAMAÑO  
general coordinator

GROUND FLOOR STRUCTURE



unfolding under the sun

Universidad Politécnica de Madrid (UPM)